

LAND CORNER RECORDATION CERTIFICATE

LI 29366 PA 891

Filing Requirement of Act 74, Mich. P.A. 1970

J-09 Page 1

For corners in

Wayne County

Located in: Sumpter Corner Code

1. Public Land Survey	T 4 S R 8 E	J-09
	T R	
	T R	
	T R	
2. Property Controlling in Section	S T R	
	S T R	
3. Miscellaneous Property in Sec.	S T R	
	S T R	
4. Lot No. _____, Recorded Plat _____		
5. Private Claims _____		

Compliance with ACT 345, P.A. 1990

APPROVED ON: 12-16-96
WAYNE COUNTY REMONUMENTATION PEER GROUP COMMITTEE

Register of Deeds Stamp and File Number

	A	B	C	D	E	F	G	H	I	J	K	L	M
2	6	5	4	3	2	1							
3													
4	7	8	9	10	11	12							
5													
6	18	17	16	15	14	13							
7													
8	19	20	21	22	23	24							
9													
10	30	29	28	27	26	25							
11													
12	31	32	33	34	35	36							
13													

I, Kenneth S. Wilkerson in a field survey on 02/01/1996 do hereby certify that under requirements of P.A. 74, Michigan P.A. of 1970, the corner points mentioned in lines 1 and 2 above were in conformance with regulations and rules therefore as required in the current manual of survey instructions of the United States Department of the Interior, Bureau of Land Management. or by a decree of a Court of Law and/or that the corner points mentioned in lines 3, 4 and 5 above were in conformance with the rules of the Michigan Board of Land Surveyors or by a Decree of a Court of Law, established, re-established, monumented, re-monumented, recovered, found as expressed below.

NOTE: Not more than 4 corners, all in the same town and range, may be recorded on this certificate.

A. Description of original monument and accessories and/or subsequent restorations:

01/01/1816 Wampler G.L.O. Set post
NO WITNESSES REMAIN ON THIS CORNER

(Witnesses Continued on Back ...)

B. Description of corner evidence found and/or method applied in restoring or reestablishing corner:

Fd. 1/2" iron rod in mon. box in asph. pave in Willow, dist to K-09 = 2672.46'(R) 2672.76'(M) and to I-09 = 2647.52'(R) 2647.95'(M)

C. Description of monument for corner and accessories established to perpetuate locating the position of the corner:


02/01/1996 Wilkerson 21584 O.H.M. Remon

- SET W.C.R. CAP AND WASHER OVER FD. 1/2" IRON ROD
- 7 DUE SOUTH Fd 3/4" IRON PIPE 33.00' (R&M)
- 9 N 1 W SET WCR TAG ON E SIDE FENCE POST 44.30'
- 10 N 22 E SET PK ON CONC. HEADWALL 29.70'
- 11 N 53 E SET WCR TAG ON S SIDE OF POLE 59.15'

\$ 10.00 DEED
30 DEC 96 1:37 P.M. RECEIPT# 44B
RECORDED
FOREST E. YOUNGBLOOD, REGISTER OF DEEDS
WAYNE COUNTY, MI
\$ 4.00 REMONUMENTATION

We conclude that after careful study of the record documentation and field observations, that this corner is accepted as the best available evidence of the position of the original corner.

Signed by Kenneth S. Wilkerson Date DEC 22 1996
Drafted by Kenneth S. Wilkerson
Surveyor's Michigan License No. 21584
Orchard, Hiltz and McCliment, Inc. 34935 Schoolcraft Road Livonia, MI 48150

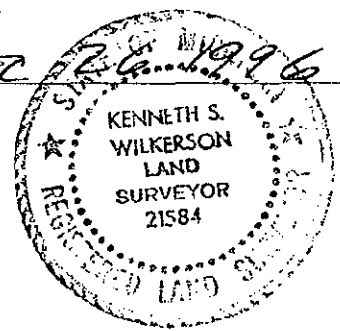

4k
106
D02

A. (Continued) Description of original monument and accessories and/or subsequent restorations:

01/01/1930

W.C. B/T

Set Iron

- 1 8" ELM NE 32.00' (gone)
- 2 8" ELM NE 55.34' (gone)
- 3 8" ELM SE 51.84' (gone)
- 4 8" ELM SW 50.68' (gone)
- 5 8" ELM NW 75.32' (gone)

LI29366PA892

06/01/1970

W.C.R.C.

Mon in mon box

- 6 M.B.T. POLE N 34.90' (gone)
- 7 IRON S 33.00' (R&M)
- 8 GUY POLE SW 32.28' (gone)

06/30/1970

Johns

W.C.R.C.

Mon. w/ box

SAME AS ABOVE