

**LAND CORNER RECORDATION CERTIFICATE**

Filing Requirement of Act 74, Mich. P.A. 1970

J-13 Page 1

For corners in

Wayne

Located in: Sumpter Corner Code

County

|                                       |         |                           |       |
|---------------------------------------|---------|---------------------------|-------|
| 1. Public Land Survey                 |         | T <u>4</u> S R <u>8</u> E | J-13  |
|                                       |         | T _____ R _____           | _____ |
|                                       |         | T _____ R _____           | _____ |
|                                       |         | T _____ R _____           | _____ |
| 2. Property Controlling in Section    | S _____ | T _____ R _____           | _____ |
|                                       | S _____ | T _____ R _____           | _____ |
| 3. Miscellaneous Property in Sec.     | S _____ | T _____ R _____           | _____ |
|                                       | S _____ | T _____ R _____           | _____ |
| 4. Lot No. _____, Recorded Plat _____ |         |                           |       |
| 5. Private Claims _____               |         |                           |       |

**LI 29366 PA 893**

Compliance with ACT 345, P.A. 1990

APPROVED ON: 12-16-96 JPS  
**WAYNE COUNTY REMONUMENTATION PEER GROUP COMMITTEE**

Register of Deeds Stamp and File Number

|    |    |    |    |    |    |    |   |   |   |   |   |   |   |
|----|----|----|----|----|----|----|---|---|---|---|---|---|---|
|    | A  | B  | C  | D  | E  | F  | G | H | I | J | K | L | M |
| 2  | 6  | 5  | 4  | 3  | 2  | 1  |   |   |   |   |   |   |   |
| 3  |    |    |    |    |    |    |   |   |   |   |   |   |   |
| 4  | 7  | 8  | 9  | 10 | 11 | 12 |   |   |   |   |   |   |   |
| 5  |    |    |    |    |    |    |   |   |   |   |   |   |   |
| 6  | 18 | 17 | 16 | 15 | 14 | 13 |   |   |   |   |   |   |   |
| 7  |    |    |    |    |    |    |   |   |   |   |   |   |   |
| 8  | 19 | 20 | 21 | 22 | 23 | 24 |   |   |   |   |   |   |   |
| 9  |    |    |    |    |    |    |   |   |   |   |   |   |   |
| 10 | 30 | 29 | 28 | 27 | 26 | 25 |   |   |   |   |   |   |   |
| 11 |    |    |    |    |    |    |   |   |   |   |   |   |   |
| 12 | 31 | 32 | 33 | 34 | 35 | 36 |   |   |   |   |   |   |   |
| 13 |    |    |    |    |    |    |   |   |   |   |   |   |   |

I, Kenneth S. Wilkerson in a field survey on 02/01/1996 do hereby certify that under requirements of P.A. 74, Michigan P.A. of 1970, the corner points mentioned in lines 1 and 2 above were in conformance with regulations and rules therefore as required in the current manual of survey instructions of the United States Department of the Interior, Bureau of Land Management. or by a decree of a Court of Law and/or that the corner points mentioned in lines 3, 4 and 5 above were in conformance with the rules of the Michigan Board of Land Surveyors or by a Decree of a Court of Law, established, re-established, monumented, re-monumented, recovered, found as expressed below.

NOTE: Not more than 4 corners, all in the same town and range, may be recorded on this certificate.

A. Description of original monument and accessories and/or subsequent restorations:

12/07/1815 Wampler G.L.O. Set post  
 18" W.O. S. 79 LINKS E. 7 LINKS (gone)  
 12" W.O. N. 44 LINKS W. 19 LINKS (gone)

(Witnesses Continued on Back ...)

B. Description of corner evidence found and/or method applied in restoring or reestablishing corner:

set 1/2" I.R. in mon box. in conc. Oakville-Waltz using Spalding Dedecker witnesses, dist from I-13 = 2560.66(R) 2560.66(M) and to K-13 = 2553.91(R) 2554.53 (M)

C. Description of monument for corner and accessories established to perpetuate locating the position of the corner:

02/01/1996 Wilkerson 21584 O.H.M. Remon


- SET W.C.R. CAP AND WASHER OVER CORNER
- CORNER IS NOT COMMON
- 3 MON. WEST 308.45 (M) 307.85' (R)
- 9 HYD. NE 35.40'
- 11 TWIN TREE SW 41.43'
- 13 TREE NE 31.11'
- 14 8" TRIPLE ELM SW 59.35'

\$ 4.00 REMONUMENTATION  
 30 DEC 96 1:37 P.M. RECEIPT# 44B  
 RECORDED  
 FOREST E. YOUNGBLOOD, REGISTER OF DEEDS  
 WAYNE COUNTY, MI  
 \$ 10.00 DEED

We conclude that after careful study of the record documentation and field observations, that this corner is accepted as the best available evidence of the position of the original corner.

Signed by [Signature]  
 Drafted by Kenneth S. Wilkerson  
 Surveyor's Michigan License No. 21584  
 Orchard, Hiltz and McCliment, inc. 34935 Schoolcraft Road Livonia, MI 48150

Date

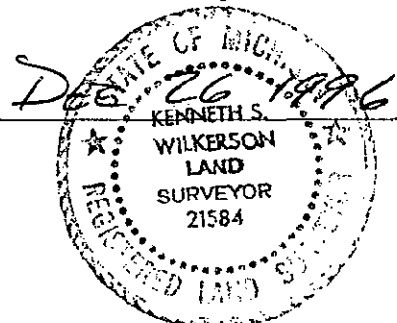

4  
10  
JPS

A. (Continued) Description of original monument and accessories and/or subsequent restorations:

01/01/1930 W.C. B/T Iron

- 1 CROSS ON CULVERT HEADWALL NW. 23.31' (gone)
- 2 CROSS ON CULVERT HEADWALL SW 23.34' (gone)
- 3 MON. W. 307.85' (R) 308.45' (M)
- 4 GUARD P. SW 24.42' (gone)

LI29366PA894

01/01/1970 W.C.R.C. IRON

- 1 CROSS ON CULV. HEADWALL NW 23.50' (gone)
- 2 CROSS ON CULV. HEADWALL SW 23.40' (gone)
- 5 10" ELM NE 41.15' (gone)
- 6 12" ELM SE 37.40' (gone)
- 7 12" ELM SW 67.80' (gone)
- 8 12" ELM NW 45.45' (gone)

12/03/1993 Platz 38121 Spalding, 1376 PK NAIL  
Dedecker, &  
ASSOC.

- 9 AZ. 46D 35.40' CENTERLINE OF HYDRANT (R) (M)
- 11 AZ 227D 41.43' PKNAIL TAG #21563 NW FACE TW 8' ELM (R) (M)
- 13 AZ. 17D 31.11' SET PK NAIL IN E. FACE OF UTILITY P (R) (M)
- 14 AZ. 244D 59.35' 16'D' NAIL N FACE TRIPLE 8" ELM (R) (M)