

FEB 28 1994

COMMISSION

RC 1330

LAND CORNER RECORDATION CERTIFICATE 27042PA352

Filing Requirement of Act 74, Mich. P.A. 1970

For corners in

<u>Wayne</u>			
County:		Located in:	Corner Code #
SUMPTER TOWNSHIP			
1. Public Land Survey		T <u>4 S</u> R <u>8 E</u>	<u>K-02</u>
		T _____ R _____	_____
		T _____ R _____	_____
		T _____ R _____	_____
2. Property Controlling in Section	S _____	T _____ R _____	_____
	S _____	T _____ R _____	_____
3. Miscellaneous Property in Sec.	S _____	T _____ R _____	_____
	S _____	T _____ R _____	_____
4. Lot No. _____, Recorded Plat _____			
5. Private Claims _____			

Compliance with ACT 345, P.A. 1990

APPROVED ON: 12-15-93 D.P.J.
WAYNE COUNTY REMONUMENTATION PEER GROUP COMMITTEE

Register of Deeds Stamp & File Number

RC 1330

I, Kenneth S. Wilkerson in a field survey on October 04, 19 93, do hereby certify that under requirements of P.A. 74, Michigan P.A. of 1970, the corner points mentioned in lines 1 and 2 above were in conformance with regulations and rules therefore as required in the current manual of survey instructions of the United States Department of the Interior, Bureau of Land Management or by a decree of a Court of Law and/or that the corner points mentioned in lines 3, 4 and 5 above were in conformance with the rules of the Michigan Board of Land Surveyors or by a Decree of a Court of Law; established, re-established, monumented, re-monumented, recovered, found as expressed below:

NOTE: Not more than 4 corners, all in the same town and range, may be recorded on this certificate.

A. Description of original monument and accessories and/or subsequent restoration:

K-02 Set Post - GLO - NO GLO WITNESSES REMAIN
Fd. Mon - B of T
Fd. RR Spike - WCRC - 6/17/73
Fd mon in mon box, L. 18401, P. 82 - 3/29/73

N 113.83 top nut on hyd
E 7.74 RR spike in center line rd
SE 49.56 WCRC sign post
SW 41.34 iron
SW 42.01 PK in fence post
NW 70.22 PK in 10" tree

B. Description of corner evidence found and/or method applied in restoring or reestablishing corner:

K-02 Fd 1/2" rod mon box 6" below rd
Verified from corner recordation certificate per L. 18401, P. 82

C. Description of monument for corner and accessories established to perpetuate locating the position of the corner:


Set Wayne County remonumentation washer and OHM - KSW 21584 cap on iron.

K-02 060 az 71.61 NW face 12" cottonwood
135 az 77.50 NE face 10" ash
150 az 49.88 NE bolt on light base
325 az 50.04 W face 12" oak

The selected location is accepted as the best evidence of the position of the original corner.

Signed by: [Signature]

Date: _____

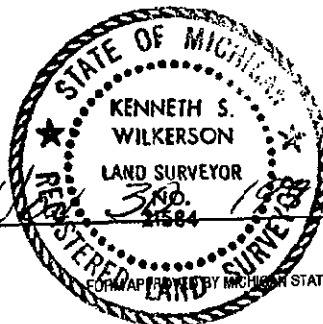

Drafted By: Kenneth S. Wilkerson
Surveyor's Michigan License No. 21584

Orchard, Hiltz & McCliment, Inc.
34935 Schoolcraft Road * Livonia, Michigan 48150 * Phone: (313) 522-6711

REVISED MAY 14, 1976
REVISED JAN., 1983

28
11KJ

93 DEC 15 PM 4:59
