

FEB 29 1993

RC 1332

LAND CORNER RECORDATION CERTIFICATE
Filing Requirement of Act 74, Mich. P.A. 1970

L127042PA354

For corners in

Wayne

County:

SUMPTER TOWNSHIP

Located in:

Corner Code #

1. Public Land Survey		T <u>4 S</u>	R <u>8 E</u>	<u>K-07</u>
		T _____	R _____	_____
		T _____	R _____	_____
		T _____	R _____	_____
2. Property Controlling in Section	S _____	T _____	R _____	_____
	S _____	T _____	R _____	_____
3. Miscellaneous Property in Sec.	S _____	T _____	R _____	_____
	S _____	T _____	R _____	_____

Compliance with
ACT 345, P.A. 1990
APPROVED ON: 12-15-93
WAYNE COUNTY REMONUMENTATION
PEER GROUP COMMITTEE

Register of Deeds Stamp & File Number

RC 1332

4. Lot No. _____, Recorded Plat _____

5. Private Claims _____

I, Kenneth S. Wilkerson, in a field survey on October 09, 1993, do hereby certify that under requirements of P.A. 74, Michigan P.A. of 1970, the corner points mentioned in lines 1 and 2 above were in conformance with regulations and rules therefore as required in the current manual of survey instructions of the United States Department of the Interior, Bureau of Land Management or by a decree of a Court of Law and/or that the corner points mentioned in lines 3, 4 and 5 above were in conformance with the rules of the Michigan Board of Land Surveyors or by a Decree of a Court of Law, established, re-established, monumented, re-monumented, recovered, found as expressed below:

A	B	C	D	E	F	G	H	I	J	K	L	M
2	6	5	4	3	2	1						
3												
4	7	8	9	10	11	12						
5												
6	18	17	16	15	14	13						
7												
8	19	20	21	22	23	24						
9												
10	30	29	28	27	26	25						
11												
12	31	32	33	34	35	36						
13												

NOTE: Not more than 4 corners, all in the same town and range, may be recorded on this certificate.

A. Description of original monument and accessories and/or subsequent restoration:

K-07 Set Post - GLO - NO GLO WITNESSES REMAIN
Set iron - B of T

Fence E & W and N & S
SW 62.12 nail in W face 14" hickory
SW 95.83 nail in NW face 16" hickory
W 28.13 nail in S face fence post

B. Description of corner evidence found and/or method applied in restoring or reestablishing corner:

K-07 Fd 3/4" pipe w/RR spike inside iron is 0.30 W of 10" post

C. Description of monument for corner and accessories established to perpetuate locating the position of the corner:

Set Wayne County remonumentation washer and OHM - KSW 21584 cap on iron.

K-07 000 az 22.25 OHM tag S face 10" elm
003 az 33.05 OHM tag W face 18" poplar
193 az 61.20 OHM tag W face 16" hickory
251 az 21.93 OHM tag SE face 14" W oak


The selected location is accepted as the best evidence of the position of the original corner.

Signed by: [Signature]

Date: _____

Drafted By: Kenneth S. Wilkerson
Surveyor's Michigan License No. 21584

Orchard, Hiltz & McCliment, Inc.
34935 Schoolcraft Road * Livonia, Michigan 48150 * Phone: (313) 522-6711

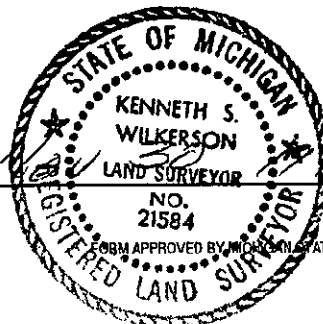

FORM APPROVED BY MICHIGAN STATE BOARD OF LAND SURVEYORS, JAN. 28, 1971
REVISED MAY 14, 1975
REVISED JAN., 1983

2R
11K

93 DEC 15 PM 4:59
FOREST E. YOUNGBLOOD
REGISTER OF DEEDS
WAYNE COUNTY, MI