

LAND CORNER RECORDATION CERTIFICATE

Filing Requirement of Act 74, Mich. P.A. 1970

K-09 Page 1

For corners in

Wayne

Located in: Sumpter Corner Code

LI29366PA897

1. Public Land Survey		T <u>4</u> S	R <u>8</u> E	<u>K-09</u>
		T _____	R _____	_____
		T _____	R _____	_____
		T _____	R _____	_____
2. Property Controlling in Section	S	T _____	R _____	_____
	S	T _____	R _____	_____
3. Miscellaneous Property in Sec.	S	T _____	R _____	_____
	S	T _____	R _____	_____

Compliance with
ACT 345, P.A. 1990

APPROVED ON: 12-16-96 *PSJ*
WAYNE COUNTY REMONUMENTATION
PEER GROUP COMMITTEE

Register of Deeds Stamp and File Number

4. Lot No. _____, Recorded Plat _____
5. Private Claims _____

	A	B	C	D	E	F	G	H	I	J	K	L	M
2	6	5	4	3	2	1							
3													
4	7	8	9	10	11	12							
5													
6	18	17	16	15	14	13							
7													
8	19	20	21	22	23	24							
9													
10	30	29	28	27	26	25							
11													
12	31	32	33	34	35	36							
13													

I, Kenneth S. Wilkerson in a field survey on 02/01/1996
do hereby certify that under requirements of P.A. 74, Michigan P.A. of 1970, the corner points mentioned in lines 1 and 2 above were in conformance with regulations and rules therefore as required in the current manual of survey instructions of the United States Department of the Interior, Bureau of Land Management, or by a decree of a Court of Law and/or that the corner points mentioned in lines 3, 4 and 5 above were in conformance with the rules of the Michigan Board of Land Surveyors or by a Decree of a Court of Law, established, re-established, monumented, re-monumented, recovered, found as expressed below.

NOTE: Not more than 4 corners, all in the same town and range, may be recorded on this certificate.

A. Description of original monument and accessories and/or subsequent restorations:

01/01/1816 Wampler G.L.O. Set post
REMAIN AT THIS CORNER
NO WITNESSES

(Witnesses Continued on Back ...)

B. Description of corner evidence found and/or method applied in restoring or reestablishing corner:

Fd. 1/2" iron rod in mon box at Willow and ^{HAGGETTY RD.} Martineville. Dist to J-09 = 2672.46'(R) 2672.76'(M), to L-09 = 2635.96'(R) 2637.63'(M) and to K-09 = 2637.90 (R) 2638.40' (M), and Roskelly 2638.33' (Asph.)
.68

C. Description of monument for corner and accessories established to perpetuate locating the position of the corner:


02/01/1996 Wilkerson 21584 O.H.M. Remon
SET W.C.R. CAP AND WASHER OVER FD. 1/2" IRON ROD.
6 NE Fd PK S SIDE OF DE POLE 52.30'
7 N 60 W C.L. GATE 69.10'
8 N 65 W C.L. HYD. 79.50'
9 S 40 W C.L. CONC. M.H. COVER ON ELEC M.H. 66.45'

\$ 10.00 DEED
30 DEC 96 1:37 P.M. RECEIPT# 44B
RECORDED
FOREST E. YOUNGBLOOD, REGISTER OF DEEDS
WAYNE COUNTY, MI
\$ 4.00 REMONUMENTATION

We conclude that after careful study of the record documentation and field observations, that this corner is accepted as the best available evidence of the position of the original corner.

Signed by *Kenneth S. Wilkerson*
Drafted by Kenneth S. Wilkerson
Surveyor's Michigan License No. 21584
Orchard, Hiltz and McCliment, Inc. 34935 Schoolcraft Road Livonia, MI 48150

Date DEC 22 1996

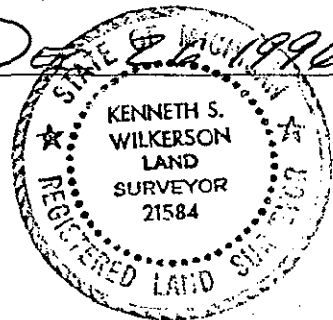

*4K
10L
DP.*

A. (Continued) Description of original monument and accessories and/or subsequent restorations:

01/01/1930	W.C. B/T	Iron	L129366PA898
1	CROSS ON W.C.R. SIGN POST SE 35.55' (gone)		
2	U.S.C. & G. MON. SW 45.70' (gone)		
3	28" POPLAR NW 50.90' (gone)		
06/01/1970	W.C.R.C.	Mon in mon box	
2	CENTER OF U.S.C. & G. MON. SW 45.83' (gone)		
4	M.B.T. POLE NE 49.07' (gone)		
5	W.C.R.C. RD. SIGN SE 40.91' (gone)		
06/17/1970	Johns SAME AS ABOVE	W.C.R.C. Mon.	