

**LAND CORNER RECORDATION CERTIFICATE**

Filing Requirement of Act 74, Mich. P.A. 1970

K-10 Page 1

**LI 29366 PA 895**

For corners in  
Wayne  
County

Located in: Sumpter Corner Code

|                                       |   |   |   |   |   |   |   |      |
|---------------------------------------|---|---|---|---|---|---|---|------|
| 1. Public Land Survey                 |   | T | 4 | S | R | 8 | E | K-10 |
|                                       |   | T |   |   | R |   |   |      |
|                                       |   | T |   |   | R |   |   |      |
|                                       |   | T |   |   | R |   |   |      |
| 2. Property Controlling in Section    | S | T |   |   | R |   |   |      |
|                                       | S | T |   |   | R |   |   |      |
| 3. Miscellaneous Property in Sec.     | S | T |   |   | R |   |   |      |
|                                       | S | T |   |   | R |   |   |      |
| 4. Lot No. _____, Recorded Plat _____ |   |   |   |   |   |   |   |      |
| 5. Private Claims _____               |   |   |   |   |   |   |   |      |

Compliance with  
ACT 345, P.A. 1990

APPROVED ON: 12-16-96  
WAYNE COUNTY REMONUMENTATION  
PEER GROUP COMMITTEE

Register of Deeds Stamp and File Number

I, Kenneth S. Wilkerson in a field survey on 02/23/1996 do hereby certify that under requirements of P.A. 74, Michigan P.A. of 1970, the corner points mentioned in lines 1 and 2 above were in conformance with regulations and rules therefore as required in the current manual of survey instructions of the United States Department of the Interior, Bureau of Land Management, or by a decree of a Court of Law and/or that the corner points mentioned in lines 3, 4 and 5 above were in conformance with the rules of the Michigan Board of Land Surveyors or by a Decree of a Court of Law, established, re-established, monumented, re-monumented, recovered, found as expressed below.

NOTE: Not more than 4 corners, all in the same town and range, may be recorded on this certificate.

|    |    |    |    |    |    |    |   |   |   |   |   |   |   |
|----|----|----|----|----|----|----|---|---|---|---|---|---|---|
|    | A  | B  | C  | D  | E  | F  | G | H | I | J | K | L | M |
| 2  | 6  | 5  | 4  | 3  | 2  | 1  |   |   |   |   |   |   |   |
| 3  |    |    |    |    |    |    |   |   |   |   |   |   |   |
| 4  | 7  | 8  | 9  | 10 | 11 | 12 |   |   |   |   |   |   |   |
| 5  |    |    |    |    |    |    |   |   |   |   |   |   |   |
| 6  | 18 | 17 | 16 | 15 | 14 | 13 |   |   |   |   |   |   |   |
| 7  |    |    |    |    |    |    |   |   |   |   |   |   |   |
| 8  | 19 | 20 | 21 | 22 | 23 | 24 |   |   |   |   |   |   |   |
| 9  |    |    |    |    |    |    |   |   |   |   |   |   |   |
| 10 | 30 | 29 | 28 | 27 | 26 | 25 |   |   |   |   |   |   |   |
| 11 |    |    |    |    |    |    |   |   |   |   |   |   |   |
| 12 | 31 | 32 | 33 | 34 | 35 | 36 |   |   |   |   |   |   |   |
| 13 |    |    |    |    |    |    |   |   |   |   |   |   |   |

A. Description of original monument and accessories and/or subsequent restorations:

01/01/1816 Wampler G.L.O. Set post  
18" MAPLE N. 60 LINKS E. 33 LINKS (GONE)  
24" B.O. S. 60 LINKS W. 12 LINKS (GONE)

(Witnesses Continued on Back ...)

B. Description of corner evidence found and/or method applied in restoring or reestablishing corner:

Fd. 1" iron rod 4' west of centerline Haggerty rd. (gravel) 6" deep. Dist to K-09 = 2637.90'(R) 2638.40'(M),  
Roskelly to K-09 = 2638.33' and to K-11 = 2634.64'(R) 2634.97'(M)

C. Description of monument for corner and accessories established to perpetuate locating the position of the corner:

02/23/1996 Wilkerson 21584 O.H.M. Remon.  
SET W.C.R.C. CAP AND WASHER OVER FD. 1" IRON ROD.  
6 N60E 41.09' FD. P.K. NAIL AND TAG IN N. SIDE TWIN 13" OAK  
9 S45E 44.90' TO FD. P.K. NAIL IN N. SIDE 20" OAK.  
10 EAST 33.02' TO FD. CONC. MON.  
15 N85W 40.05' TO FD. P.K. NAIL IN S. SIDE 19" OAK.  
18 N85E 36.57' SET NAIL AND W.C. REMON TAG IN S. SIDE TWIN 8" OAK.


\$ 4.00 REMONUMENTATION  
30 DEC 96 1:38 P.M. RECEIPT# 44B  
RECORDED  
FOREST E. YOUNGBLOOD, REGISTER OF DEEDS  
WAYNE COUNTY, MI  
\$ 10.00 DEED

We conclude that after careful study of the record documentation and field observation that this corner is accepted as the best available evidence of the position of the original corner.

Signed by [Signature]  
Drafted by Kenneth S. Wilkerson  
Surveyor's Michigan License No. 21584  
Orchard, Hiltz and McCliment, Inc. 34935 Schoolcraft Road Livonia, MI 48150

Date

DEC 26 1996

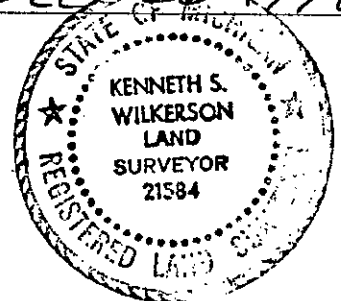

4K  
06  
[Signature]

## A. (Continued) Description of original monument and accessories and/or subsequent restorations:

|            |   |          |      |                          |
|------------|---|----------|------|--------------------------|
| 01/01/1930 |   | W.C. B/T |      | Fd. iron                 |
| 1          | 16" Oak SE 51.24' (gone)  |          |      |                          |
| 2          | 10" Elm SW 25.05' (gone)  |          |      |                          |
| 3          | F.P. Westerly 22.00' (gone)                                       |          |      |                          |
| 4          | 20" Oak NW. 78.47' (gone)   |          |      |                          |
| 5          | 14" Oak NW 103.50' (gone)   |          |      |                          |
| 02/01/1967 |   | W.C.R.C. |      | IRON                     |
| 4          | 26" OAK W 78.47' (gone)   |          |      |                          |
| 5          | 20" OAK NW 103.50' (gone)   |          |      |                          |
| 6          | 8" OAK NE 40.84' (R) 41.09' (M)                                   |          |      |                          |
| 7          | 20" OAK SE 61.10' (gone)  |          |      |                          |
| 8          | 22" OAK S 46.76' (gone)   |          |      |                          |
| 06/17/1970 | Johns   | W.C.R.C. |      | Iron                     |
| 4          | 32" OAK NW 77.75' (gone)  |          |      |                          |
| 6          | 18" TWIN OAK NE 40.38' (R) 41.09' (M)                             |          |      |                          |
| 9          | TWIN 12" OAKS SE 45.58' (R) 44.90' (M)                            |          |      |                          |
| 10         | IRON W 33.00' (R) 33.02' (M)                                      |          |      |                          |
| 06/24/1974 | Crossnam  | 9428     | 339  | Fd. iron pipe            |
| 6          | Nail & cap in S. side 16" Oak N.65 E.40.40 (R) 41.09" (M)         |          |      |                          |
| 9          | Nail & cap in SW. side twin 14" Oak S.50 E. 45.68' (R) 44.90' (M) |          |      |                          |
| 10         | Iron rod W. 32.80' (R) 33.02' (M)                                 |          |      |                          |
| 09/04/1974 | Roskelly  | 18663    |      | Iron pipe                |
| 6          | NAIL & TAG IN 10" TWIN RED OAK N 60 E 40.43' (R) 41.09' (M)       |          |      |                          |
| 9          | NAIL & TAG IN 10" TRIPLE RED OAK S 45 E 45.66' (R) 44.90' (M)     |          |      |                          |
| 10         | IRON BAR WEST 32.80' (R) 33.02' (M)                               |          |      |                          |
| 05/12/1975 | Crossman  | 9428     | 420  | Fd. Iron pipe            |
|            | SAME AS ABOVE   |          |      |                          |
| 02/04/1986 | Richard   | 13040    | 870  | Fd. 5/8" rerod           |
| 10         | Re-rod W. 33.09' (R) 33.02' (M)                                   |          |      |                          |
| 12         | N.E. cor. hse. N. 45 W. 125.2 (gone)                              |          |      |                          |
| 13         | S. E. cor. hse. N. 75 W. 89.25' (gone)                            |          |      |                          |
| 14         | N. W. cor. hse. N. 80 W. 125.0' (gone)                            |          |      |                          |
| 04/30/1991 | Stonerock   | 13601    | 1007 | Fd. 5/8" iron rod (bent) |
| 9          | PK in face twin 16" Oak S.50 E. 44.83' (R) 44.90' (M)             |          |      |                          |
| 15         | PK in S. face of 18" Oak N. 88 W. 40.13'(R) 40.05' (M)            |          |      |                          |
| 16         | PK & cap in NW. face twin 12" Oak N.56 W. 40.86' (gone)           |          |      |                          |
| 17         | PK & cap in E. face twin 20" Pine.S.15 W. 121.73' (gone)          |          |      |                          |

LI29866PA896