

FEB 23 1984

COMMISSION

# RC 1333

LAND CORNER RECORDATION CERTIFICATE  
Filing Requirement of Act 74, Mich. P.A. 1970

LI27042PA355

For corners in

Wayne  
County:  
SUMPTER TOWNSHIP

Located in: Corner Code #

1. Public Land Survey T 4 S R 8 E K-11  
T \_\_\_\_\_ R \_\_\_\_\_  
T \_\_\_\_\_ R \_\_\_\_\_  
T \_\_\_\_\_ R \_\_\_\_\_

2. Property Controlling S \_\_\_\_\_  
in Section S \_\_\_\_\_ T \_\_\_\_\_ R \_\_\_\_\_  
S \_\_\_\_\_ T \_\_\_\_\_ R \_\_\_\_\_

3. Miscellaneous S \_\_\_\_\_ T \_\_\_\_\_ R \_\_\_\_\_  
Property in Sec. S \_\_\_\_\_ T \_\_\_\_\_ R \_\_\_\_\_

4. Lot No. \_\_\_\_\_, Recorded Plat \_\_\_\_\_

5. Private Claims \_\_\_\_\_

Compliance with  
ACT 345, P.A. 1990

APPROVED ON: 12-15-93 *Doj*

WAYNE COUNTY REMONUMENTATION  
PEER GROUP COMMITTEE

Register of Deeds Stamp & File Number

RC 1333

I, Kenneth S. Wilkerson, in a field survey on October 04, 1993, do hereby certify that under requirements of P.A. 74, Michigan P.A. of 1970, the corner points mentioned in lines 1 and 2 above were in conformance with regulations and rules therefore as required in the current manual of survey instructions of the United States Department of the Interior, Bureau of Land Management or by a decree of a Court of Law and/or that the corner points mentioned in lines 3, 4 and 5 above were in conformance with the rules of the Michigan Board of Land Surveyors or by a Decree of a Court of Law; established, re-established, monumented, re-monumented, recovered, found as expressed below:

NOTE: Not more than 4 corners, all in the same town and range, may be recorded on this certificate.

A. Description of original monument and accessories and/or subsequent restoration:

- K-11 Set Post - GLO - NO GLO WITNESSES REMAIN  
Set Iron - B of T  
Fd. Iron - WCRC - 6/17/70  
Fd. Iron Pipe - L. 18845, P. 280 - 6/14/74  
Fd. Iron Pipe - L. 19097, P. 736 - 2/19/75  
Fd. 1/2" Iron Rod - L. 24962, P. 740 - 6/01/89  
Fd 1/4" iron, L. 25188, P. 949 - 4/30/91

- N 80 W 137.42 cap in S face PP  
N 53 E 56.87 cap in NW face PP  
S 79 E 134.00 cap in N face 20' oak  
S 18 W 105.05 cap in E face 6" elm

B. Description of corner evidence found and/or method applied in restoring or reestablishing corner:

- K-11 Fd. 1/2" rod  
Verified based on witness and observation per L. 24692, P. 740

C. Description of monument for corner and accessories established to perpetuate locating the position of the corner:

- Set Wayne County remonumentation washer and OHM - KSW 21584 cap on iron.
- K-11 060 az 56.92 PK & tag NW face PP  
107 az 124.05 PK & tag N face 18" oak  
120 az 80.75 top nut on hyd  
306 az 56.75 OHM tag SW face PP

The selected location is accepted as the best evidence of the position of the original corner.


Signed by: *[Signature]*

Date: 30 1993

Drafted By: Kenneth S. Wilkerson  
Surveyor's Michigan License No. 21584

Orchard, Hiltz & McCliment, Inc.  
34936 Schoolcraft Road \* Livonia, Michigan 48150 \* Phone: (313) 522-6711

A	B	C	D	E	F	G	H	I	J	K	L	M
2	6	5	4	3	2	1						
3												
4	7	8	9	10	11	12						
5												
6	18	17	16	15	14	13						
7												
8	19	20	21	22	23	24						
9												
10	30	29	28	27	26	25						
11												
12	31	32	33	34	35	36						
13												

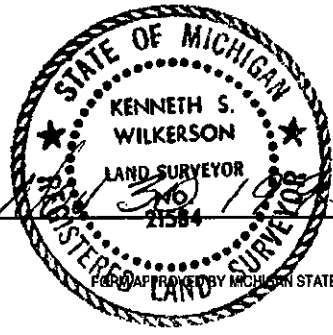

FOREST E. YOUNGBLOOD  
REGISTERED DEEDS  
WAYNE COUNTY, MI

93 DEC 15 PM 4:59

*2R  
HKD*