

SURVEY & REMONUMENTATION

RC 1625

L127802PA193

APR 25 1995

LAND CORNER RECORDATION CERTIFICATE

Filing Requirement of Act 74, Mich. P.A. 1970

K-12 Page 1

COMMISSION

For corners in

Wayne
County

Located in: SUMPTER Corner Code

1. Public Land Survey	T <u>4</u> S	R <u>8</u> E	<u>K-12</u>
	T	R	
	T	R	
	T	R	
2. Property Controlling In Section	S	T	R
	S	T	R
3. Miscellaneous Property In Sec.	S	T	R
	S	T	R
4. Lot No. _____, Recorded Plat _____			
5. Private Claims _____			

Compliance with
ACT 345, P.A. 1990
APPROVED ON: 12-9-94 *DPJ*
WAYNE COUNTY REMONUMENTATION
PEER GROUP COMMITTEE

Register of Deeds Stamp and File Number

	A	B	C	D	E	F	G	H	I	J	K	L
2	6	5	4	3	2	1						
3												
4	7	8	9	10	11	12						
5												
6	18	17	16	15	14	13						
7												
8	19	20	21	22	23	24						
9												
10	30	29	28	27	26	25						
11												
12	31	32	33	34	35	36						
13												

I, Kenneth S. Wilkerson in a field survey on 11/05/1993
do hereby certify that under requirements of P.A. 74, Michigan P.A. of 1970, the corner points mentioned in lines 1 and 2 above were in conformance with regulations and rules therefore as required in the current manual of survey instructions of the United States Department of the Interior, Bureau of Land Management. or by a decree of a Court of Law and/or that the corner points mentioned in lines 3, 4 and 5 above were in conformance with the rules of the Michigan Board of Land Surveyors or by a Decree of a Court of Law, established, re-established, monumented, re-monumented, recovered, found as expressed below.

NOTE: Not more than 4 corners, all in the same town and range, may be recorded on this certificate.

A. Description of original monument and accessories and/or subsequent restorations:

01/01/1819 G.L.O. SET POST
TODAY
NO WITNESSES REMAIN

(Witnesses Continued on Back ...)

B. Description of corner evidence found and/or method applied in restoring or reestablishing corner:

FD. 5/8" I.P. IN GRAVEL ROAD

C. Description of monument for corner and accessories established to perpetuate locating the position of the corner:

11/05/1993 WILKERSON 21584 O.H.M. REMON
SET W.C.R. WASHER & CAP ON CORNER.
3 W.C.R.C. TAG IN E. FACE 48" TREE S35W 79.99'
7 O.H.M. TAG W. FACE 19" OAK N85E 34.60'
9 O.H.M. TAG N.W. FACE 10" COTTONWOOD S 30 W 44.10'
10 M.B.T. H.G. SIGN POST N. EDGE S50W 48.50'


\$ 16.00 MISCELLANEOUS RECORDING
28 DEC 94 1:37 P.M. RECEIPT# 51B
RECORDED
FOREST E. YOUNGBLOOD, REGISTER OF DEEDS
WAYNE COUNTY, MI

We conclude that after careful study of the record documentation and field observations, that this corner is accepted as the best available evidence of the position of the original corner.

Signed by *Kenneth S. Wilkerson*
Drafted by Kenneth S. Wilkerson
Surveyor's Michigan License No. 21584

Date Dec 28 1994

Orchard, Illitz and McCliment, Inc. 34935 Schoolcraft Road Livonia, MI 48150

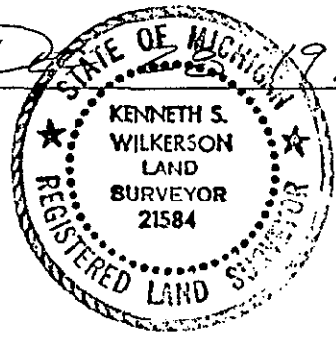

*2R
140
MISC*

A. (Continued) Description of original monument and accessories and/or subsequent restorations:

06/14/974	CROSSMAN	9428		FD. R.R. SPIKE
3	NAIL IN SE SIDE 30" OAK S20W 79.78'			
5	NAIL IN 10" OAK N88E 36.00'			
01/01/1930			W.C.B.T.	SET IRON
1	8" ELM NE 29.35'			
2	10" ELM SE 11.21'			
3	30" OAK SW 79.72'			
4	15" ELM WEST 29.88'			
05/12/1975	CROSSMAN	9428		FD. R.R. SPIKE
	SAME AS ABOVE			
01/03/1991	HOBEN	35994	O.I.L.M.	FD. R.R. SPIKE
3	NAIL IN 28" TREE S35W 79.68'			
6	GATE N40E 61.70'			
7	NAIL IN 20" TREE N65E 35.05'			
8	1/2" IRON WEST 33.00'			