

**SURVEY &
REMONUMENTATION**

RC 1437

APR 25 1995

LAND CORNER RECORDATION CERTIFICATE

LI27794PA300

COMMISSION

Filing Requirement of Act 74, Mich. P.A. 1970

K-13 Page 1

For corners in

Wayne

Located in: Sumpter Corner Code

County

- | | | | |
|---------------------------------------|---------|----------------------------------|-------------|
| 1. Public Land Survey | | T <u>4</u> S <u>R</u> <u>8</u> E | <u>K-13</u> |
| | | T _____ R _____ | _____ |
| | | T _____ R _____ | _____ |
| | | T _____ R _____ | _____ |
| 2. Property Controlling In Section | S _____ | T _____ R _____ | _____ |
| | S _____ | T _____ R _____ | _____ |
| 3. Miscellaneous Property in Sec. | S _____ | T _____ R _____ | _____ |
| | S _____ | T _____ R _____ | _____ |
| 4. Lot No. _____, Recorded Plat _____ | | | |
| 5. Private Claims _____ | | | |

Compliance with
ACT 345, P.A. 1990

APPROVED ON: 12/9/94 TCD
WAYNE COUNTY REMONUMENTATION
PEER GROUP COMMITTEE

Register of Deeds Stamp and File Number

I, Kenneth S. Wilkerson in a field survey on 06/10/1994 do hereby certify that under requirements of P.A. 74, Michigan P.A. of 1970, the corner points mentioned in lines 1 and 2 above were in conformance with regulations and rules therefore as required in the current manual of survey instructions of the United States Department of the Interior, Bureau of Land Management, or by a decree of a Court of Law and/or that the corner points mentioned in lines 3, 4 and 5 above were in conformance with the rules of the Michigan Board of Land Surveyors or by a Decree of a Court of Law, established, re-established, monumented, re-monumented, recovered, found as expressed below.

NOTE: Not more than 4 corners, all in the same town and range, may be recorded on this certificate.

	A	B	C	D	E	F	G	H	I	J	K	L	M
2	6	5	4	3	2	1							
3													
4	7	8	9	10	11	12							
5													
6	18	17	16	15	14	13							
7													
8	19	20	21	22	23	24							
9													
10	30	29	28	27	26	25							
11													
12	31	32	33	34	35	36							
13													

A. Description of original monument and accessories and/or subsequent restorations:

01/01/1819 Wampler G.L.O. Set post
8" ASH S 75 E 14 LINKS (9.24") (GONE)
24" W. OAK N 60 W 17 LINKS (11.22") (GONE)

(Witnesses Continued on Back ...)

B. Description of corner evidence found and/or method applied in restoring or reestablishing corner:

Fd. 1/2" rebar in mon. box (no lid) in asph. pvm't. @ int of cl's of Oakville-Waltz & Haggarty Rds. Dist to L-13 = 2833.04' (R), 2833.57' (M)

C. Description of monument for corner and accessories established to perpetuate locating the position of the corner:

06/10/1994 Wilkerson 21584 O.H.M. Remon.

- SET W.C.R. WASHER AND CAP OVER CORNER.
- 8 TOP BOLT ON HYDRANT N 65 W 81.83'
- 9 CENTERLINE G.V.&W. N 43 E 44.30'
- 10 W.C.R. TAG W/PK. NAIL N.W./S P.P. N.E. 72.91'
- 11 W.C.R. TAG W/PK. NAIL N.E./S P.P. N 30 W 40.16'
- 12 W.C.R. TAG W/PK. NAIL W./S P.P. S 47 E 32.76'


\$ 16.00 MISCELLANEOUS RECORDING
21 DEC 94 3:19 P.M. RECEIPT# 93A
RECORDED
FOREST E. YOUNG, REG. REGISTER OF DEEDS
WAYNE COUNTY, MI

We conclude that after careful study of the record documentation and field observations, that this corner is accepted as the best available evidence of the position of the original corner.

Signed by [Signature]
Drafted by Kenneth S. Wilkerson
Surveyor's Michigan License No. 21584

Date DEC 21 1994

Orchard, Hiltz and McCliment, Inc. 34935 Schoolcraft Road Livonia, MI 48150

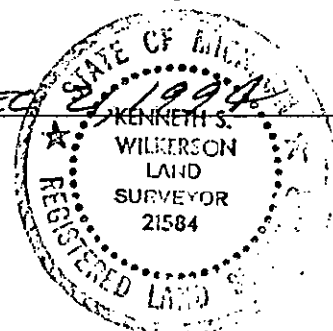

Z R
14 N - MI

A (Continued) Description of original monument and accessories and/or subsequent restorations:

01/01/1930

Wayne Co.
Bureau of
Taxation

Fd. mon.

LI27794PA301

- 1 CROSS ON CUL. HEADWALL N.W. 28.00' (GONE)
- 2 CROSS ON CUL. HEADWALL N.E. 27.46' (GONE)
- 3 CROSS IN W.C.R. SIGN N.W. 37.87' (GONE)
- 13 DIST = 2553.91' TO J-13
- 14 DIST = 2656.01' TO K-12
- 15 DIST = 2834.04' TO L-13

06/16/1970

Johns

W.C.R.C.

Fd. iron in box

- 4 M.B.T. POLE N.W. 53.88' (GONE)
- 5 W.C.R.C. SIGN N.E. 47.22' (GONE)
- 6 M.B.T. POLE S.E. 36.75' (GONE)

05/12/1975

Crossman

9428

R.C.4

Fd. iron pipe in handhole

- 4 NAIL IN SW SIDE M.B.T. POLE N 30 W 53.98' (GONE)
- 6 NAIL IN SW SIDE M.B.T. POLE S 40 E 36.80' (GONE)
- 7 W.C.R.C. SIGN N 45 W 46.85' (GONE)

06/01/1989

Hoben

35994

O.H.M. Inc.

R.C.9

Fd. iron rod in mon. box

- 4 P.K. NAIL IN E FACE OF DE POLE N 30 W 54.00'
- 6 P.K. NAIL W FACE DE POLE S 47 E 36.50'
- 8 CENTERLINE OF F. HYD. N 65 W 81.85'
- 9 CENTERLINE MH N 43 E 44.25'

01/20/1992

McCneely &
Lincoln Assoc.
Inc.

boundry

Fd. mon. box, did not recover
corner.

Dist. to L-13 = 2833.43'