

RC 1334

FEB 28 1994

COMMISSION

LAND CORNER RECORDATION CERTIFICATE  
Filing Requirement of Act 74, Mich. P.A. 1970

LI 27042 PA 356

For corners in

Wayne  
County:  
SUMPTER TOWNSHIP

Located in: Corner Code #

1. Public Land Survey T 4 S R 8 E L-03  
T \_\_\_\_\_ R \_\_\_\_\_  
T \_\_\_\_\_ R \_\_\_\_\_  
T \_\_\_\_\_ R \_\_\_\_\_

2. Property Controlling S \_\_\_\_\_ T \_\_\_\_\_ R \_\_\_\_\_  
in Section S \_\_\_\_\_ T \_\_\_\_\_ R \_\_\_\_\_

3. Miscellaneous S \_\_\_\_\_ T \_\_\_\_\_ R \_\_\_\_\_  
Property in Sec. S \_\_\_\_\_ T \_\_\_\_\_ R \_\_\_\_\_

4. Lot No. \_\_\_\_\_, Recorded Plat \_\_\_\_\_

5. Private Claims \_\_\_\_\_

Compliance with  
ACT 345, P.A. 1990  
APPROVED ON: 12-15-93 *DBJ*  
WAYNE COUNTY REMONUMENTATION  
PEER GROUP COMMITTEE

Register of Deeds Stamp & File Number

RC 1334

I, Kenneth S. Wilkerson in a field survey on October 09, 19 93, do hereby certify that under requirements of P.A. 74, Michigan P.A. of 1970, the corner points mentioned in lines 1 and 2 above were in conformance with regulations and rules therefore as required in the current manual of survey instructions of the United States Department of the Interior, Bureau of Land Management or by a decree of a Court of Law and/or that the corner points mentioned in lines 3, 4 and 5 above were in conformance with the rules of the Michigan Board of Land Surveyors or by a Decree of a Court of Law; established, re-established, monumented, re-monumented, recovered, found as expressed below:

A	B	C	D	E	F	G	H	I	J	K	L	M
2	6	5	4	3	2							
3												
4	7	8	9	10	11	12						
5												
6	18	17	16	15	14	13						
7												
8	19	20	21	22	23	24						
9												
10	30	29	28	27	26	25						
11												
12	31	32	33	34	35	36						
13												

NOTE: Not more than 4 corners, all in the same town and range, may be recorded on this certificate.

A. Description of original monument and accessories and/or subsequent restoration:

L-03 Set Post - GLO - NO GLO WITNESSES REMAIN  
Mon. - B of T  
Mon. - WCRC - 6/25/70

NE 36.21 nail in SE face 24" maple  
NE 65.58 nail in S face 12" walnut  
SE 49.30 nail in NW face PP  
SW 53.60 nail in E face 20" oak  
NW 29.26 nail in NE face Guy P  
NW 34.90 nail in W face 6" cherry

B. Description of corner evidence found and/or method applied in restoring or reestablishing corner:

L-03 Fd 1/2" rod  
Mon. was removed during water main construction per property owner.

C. Description of monument for corner and accessories established to perpetuate locating the position of the corner:


Set Wayne County remonumentation washer and OHM - KSW 21584 cap on iron.

L-03 046 az 65.80 OHM tag W face 16" walnut  
130 az 49.34 WCRC tag in PP (checks)  
224 az 52.55 OHM tag E face 30" b oak  
358 26.03 OHM tag W face twin maple

The selected location is accepted as the best evidence of the position of the original corner.

Signed by: *Kenneth S. Wilkerson*

Date: Nov 30 1993

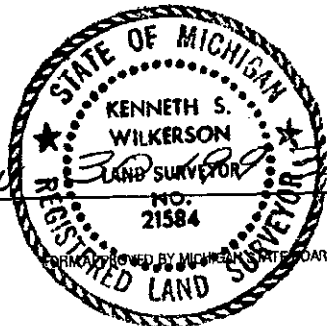

Drafted By: Kenneth S. Wilkerson  
Surveyor's Michigan License No. 21584

Orchard, Hiltz & McCliment, Inc.  
34935 Schoolcraft Road \* Livonia, Michigan 48150 \* Phone: (313) 522-6711

93 DEC 15 PM 4:59  
FOREST E. YOUNGBLOOD  
REGISTERED DEEDS  
AND INSTRUMENTS  
MICHIGAN

2R  
11K