

RC 1335

LAND CORNER RECORDATION CERTIFICATE
Filing Requirement of Act 74, Mich. P.A. 1970

LI 27042 PA 357

For corners in

Wayne
County:
SUMPTER TOWNSHIP

Located in: Corner Code #

1. Public Land Survey T 4 S R 8 E L-11
T R
T R
T R

2. Property Controlling S T R
in Section S T R

3. Miscellaneous S T R
Property in Sec. S T R

4. Lot No. _____, Recorded Plat _____

5. Private Claims _____

Compliance with
ACT 345, P.A. 1990

APPROVED ON: 12-15-93 *DBJ*
WAYNE COUNTY REMONUMENTATION
PEER GROUP COMMITTEE

Register of Deeds Stamp & File Number

RC 1335

I, Kenneth S. Wilkerson in a field survey on October 04, 19 93,
do hereby certify that under requirements of P.A. 74, Michigan P.A. of 1970, the corner points mentioned
in lines 1 and 2 above were in conformance with regulations and rules therefore as required in the current
manual of survey instructions of the United States Department of the Interior, Bureau of Land Management
or by a decree of a Court of Law and/or that the corner points mentioned in lines 3, 4 and 5 above were in
conformance with the rules of the Michigan Board of Land Surveyors or by a Decree of a Court of Law;
established, re-established, monumented, re-monumented, recovered, found as expressed below:

NOTE: Not more than 4 corners, all in the same town and range, may be recorded on this certificate.

A. Description of original monument and accessories and/or subsequent restoration:

- L-11 Set Post - GLO - NO GLO WITNESSES REMAIN
- Set Iron - B of T
- Set Iron (Bolt) - WCRC - 6/25/70
- Set 3/4" Iron Pipe - L. 18211, P. 918 - 9/27/72
- Fd. 1/2" Iron - L. 25188, P. 949 - 4/30/91

- NE 34.70 nail in NW face fence post
- NE 133.88 nail in S face 8" elm
- SE 33.08 nail in WCRC sign post
- SW 141.85 nail in SE face 20" ash
- SW 18.90 SE cor culv
- NW 18.68 NE cor culv

B. Description of corner evidence found and/or method applied in restoring or reestablishing corner:

- L-11 Fd 1/2" rod per L. 25188, P. 949

C. Description of monument for corner and accessories established to perpetuate locating the position of the corner:

Set Wayne County remonumentation washer and OHM - KSW 21584 cap on iron.

- L-11 060 az 37.47 WCRC tag NW face MBT P
- 160 az 69.15 tag W face 5" post
- 257 az 31.58 OHM tag guard rail post
- 355 az 38.60 OHM tag guard rail post


The selected location is accepted as the best evidence of the position of the original corner.

A	B	C	D	E	F	G	H	I	J	K	L	M
2	6	5	4	3	2	1						
3												
4	7	8	9	10	11	12						
5												
6	18	17	16	15	14	13						
7												
8	19	20	21	22	23	24						
9												
10	30	29	28	27	26	25						
11												
12	31	32	33	34	35	36						
13												

Signed by:

Kenneth S. Wilkerson

Date:

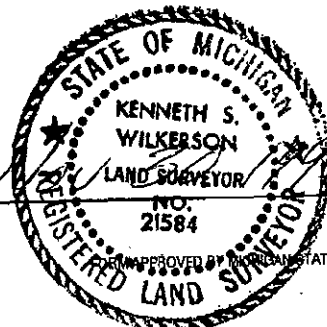

Drafted By: Kenneth S. Wilkerson
Surveyor's Michigan License No. 21584

Orchard, Hiltz & McCliment, Inc.
34935 Schoolcraft Road * Livonia, Michigan 48150 * Phone: (313) 522-6711

APPROVED BY THE STATE BOARD OF LAND SURVEYORS, JAN. 28, 1971
REVISED MAY 14, 1975
REVISED JAN., 1983

2e
11K1

FOREST E. YOUNGBLOOD
REGISTER OF DEEDS
WAYNE COUNTY, MI