

LAND CORNER RECORDATION CERTIFICATE
APR 05 1996 Filing Requirement of Act 74, Mich. P.A. 1970

For corners in **COMMISSION**

Wayne County	Located in:	Sumpter	Corner Code
1. Public Land Survey	T 4 S	R 8 E	L-13
	T	R	
	T	R	
	T	R	
2. Property Controlling in Section	S	T	R
	S	T	R
3. Miscellaneous Property in Sec.	S	T	R
	S	T	R
4. Lot No. _____, Recorded Plat _____			
5. Private Claims _____			

Compliance with ACT 345, P.A. 1990
 APPROVED ON: 11-30-95 *DBJ*
 WAYNE COUNTY REMONUMENTATION PEER GROUP COMMITTEE

Register of Deeds Stamp and File Number

	A	B	C	D	E	F	G	H	I	J	K	L	M
2	6	5	4	3	2	1							
3													
4	7	8	9	10	11	12							
5													
6	18	17	16	15	14	13							
7													
8	19	20	21	22	23	24							
9													
10	30	29	28	27	26	25							
11													
12	31	32	33	34	35	36							
13													

I, Kenneth S. Wilkerson in a field survey on 12/05/1995 do hereby certify that under requirements of P.A. 74, Michigan P.A. of 1970, the corner points mentioned in lines 1 and 2 above were in conformance with regulations and rules therefore as required in the current manual of survey instructions of the United States Department of the Interior, Bureau of Land Management. or by a decree of a Court of Law and/or that the corner points mentioned in lines 3, 4 and 5 above were in conformance with the rules of the Michigan Board of Land Surveyors or by a Decree of a Court of Law, established, re-established, monumented, re-monumented, recovered, found as expressed below.

NOTE: Not more than 4 corners, all in the same town and range, may be recorded on this certificate.

A. Description of original monument and accessories and/or subsequent restorations:

12/07/1815 Wampler G.L.O. SET POST
 1 18" W.O. S. 70 LINKS W. 17 LINKS (GONE)
 2 18" ASH N. 55 LINKS E. 20 LINKS (GONE)

(Witnesses Continued on Back ...)

B. Description of corner evidence found and/or method applied in restoring or reestablishing corner:

FD. 1/2" I.R. SET MON BOX. IN CONC. ROADWAY. DIST TO K-13 2834.04'(R) 2834.94'(M) DIST TO M-13 2646.46(R) 2646.13'(M)

C. Description of monument for corner and accessories established to perpetuate locating the position of the corner:


12/05/1995 Wilkerson 21485 O.H.M. REMON
 NOT A COMMON CORNER WITH THE TWP. TO THE SOUTH
 SET MON. BOX OVER FD. I.R. WITH REMON CAP OVER FD. IRON.
 8 W.C.R. WASHER IN S. FACE 36" ELM N83E 259.08'
 9 TO NAIL & TAG IN W. SIDE MBT POLE S43E 34.14'
 10 NAIL IN WOOD DE POLE S82W 203.02'
 11 W.C.R. WASHER IN N. SIDE DE POLE N22W 79.29'

\$ 10.00 DEED
 21 DEC 95 9:19 A.M. RECEIPT# 5B
 RECORDED
 FOREST E. YOUNGBLOOD, REGISTER OF DEEDS
 WAYNE COUNTY, MI

\$ 4.00 REMONUMENTATION

We conclude that after careful study of the record documentation and field observations, that this corner is accepted as the best available evidence of the position of the original corner.

Signed by [Signature] Date DEC 15 1995
 Drafted by Kenneth S. Wilkerson
 Surveyor's Michigan License No. 21584
 Orchard, Hiltz and McCliment, Inc. 34935 Schoolcraft Road Livonia, MI 48150

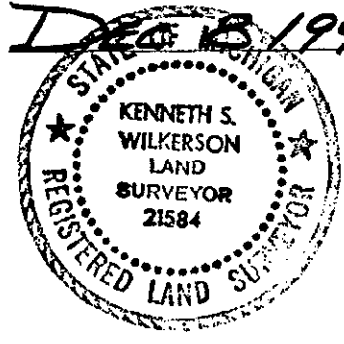

95273117

APR 10 1995

A. (Continued) Description of original monument and accessories and/or subsequent restorations:

LIBER 28477 PAGE 203
SET CROSS

01/01/1930

W.C. BUREAU
TAXATION

- 3 CROSS ON CULVERT HEADWALL NW. 41.80'
- 4 CROSS ON CULVERT HEADWALL NE. 40.95'
- 5 CROSS IN W.C.R. SIGN P. NE. 42.36'
- 6 OLD CROSS N. 0.54'
- 7 MON. W. 154.18'

FILED DO NOT MAIL