

**SURVEY &  
REMONUMENTATION**

**RC 1439**

APR 25 1995

**LAND CORNER RECORDATION CERTIFICATE**

**L127794PA304**

**COMMISSION**

Filing Requirement of Act 74, Mich. P.A. 1970

M-03 Page 1

For corners in:

Wayne County	Located In:	Sumpter	Corner Code
1. Public Land Survey	T <u>4</u> S	R <u>8</u> E	M-03
	T _____	R _____	_____
	T _____	R _____	_____
	T _____	R _____	_____
2. Property Controlling In Section	S _____	T _____	R _____
	S _____	T _____	R _____
3. Miscellaneous Property in Sec.	S _____	T _____	R _____
	S _____	T _____	R _____
4. Lot No. _____, Recorded Plat _____			
5. Private Claims _____			

Compliance with  
ACT 345, P.A. 1990

APPROVED ON: 12/9/94 HCD.  
WAYNE COUNTY REMONUMENTATION  
PEER GROUP COMMITTEE

Register of Deeds Stamp and File Number

I, Kenneth S. Wilkerson in a field survey on 06/10/1994 do hereby certify that under requirements of P.A. 74, Michigan P.A. of 1970, the corner points mentioned in lines 1 and 2 above were in conformance with regulations and rules therefore as required in the current manual of survey instructions of the United States Department of the Interior, Bureau of Land Management, or by a decree of a Court of Law and/or that the corner points mentioned in lines 3, 4 and 5 above were in conformance with the rules of the Michigan Board of Land Surveyors or by a Decree of a Court of Law, established, re-established, monumented, re-monumented, recovered, found as expressed below.

**NOTE: Not more than 4 corners, all in the same town and range, may be recorded on this certificate.**

	A	B	C	D	E	F	G	H	I	J	K	L	M
2	6	5	4	3	2	1							
3													
4	7	8	9	10	11	12							
5													
6	18	17	16	15	14	13							
7													
8	19	20	21	22	23	24							
9													
10	30	29	28	27	26	25							
11													
12	31	32	33	34	35	36							
13													

**A. Description of original monument and accessories and/or subsequent restorations:**

01/01/1819 Wampler G.L.O. Set post  
18" W. OAK N 14 W 88 LINKS (58.08') (GONE)  
12" ASH N 48 E 79 LINKS (52.14') (GONE)

(Witnesses Continued on Back ...)

**B. Description of corner evidence found and/or method applied in restoring or reestablishing corner:**

Fd. 3/4" iron pipe in gravel rds. @ int. of cl's of Clark & Willis Rds. Dist. to L-3 = 2594.84' (R), 2595.95' (M) & Dist. to A-3 = 1598.07' (R), 1599.38' (M)

**C. Description of monument for corner and accessories established to perpetuate locating the position of the corner:**

06/10/1994 Wilkerson 21584 O.H.M. Remon.


- SET 1/2" I.R. IN 1" I.P. W/W.C.R. WASHER & CAP ON CORNER.  
THIS IS NOT A COMMON CORNER WITH A-3 HURON TWP.
- 1 W.C.R. TAG W/P.K. NAIL 28" ELM S 48 W 35.85'
  - 2 W.C.R. TAG W/P.K. NAIL 28" BOX ELDER N 50 W 43.89'
  - 7 W.C.R. TAG W/P.K. NAIL IN P.P. N 32 E 30.53'
  - 8 W.C.R. TAG S.W. SIDE 20" OAK S 24 E 63.34'
  - 11 ANGLE TO R. B.S. L-3, F.S. A-3 HURON TWP. 91-22'27"

\$ 16.00 MISCELLANEOUS RECORDING  
21 DEC 94 3:13 P.M. RECEIVED 934  
REGISTERED  

We conclude that after careful study of the record documentation and field observations, that this corner is accepted as the best available evidence of the position of the original corner.

Signed by [Signature]  
Drafted by Kenneth S. Wilkerson  
Surveyor's Michigan License No. 21584

Date Dec 21 1994

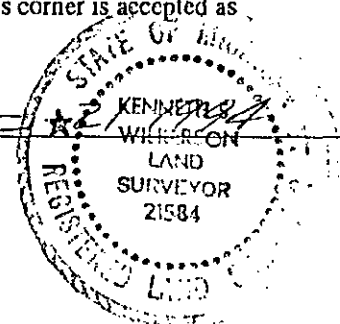

Richard, Hiltz and McCliment, Inc. 34935 Schoolcraft Road Livonia, MI 48150

2 R  
14 N - MISC.

## A (Continued) Description of original monument and accessories and/or subsequent restorations:

01/01/1930	Wayne Co. Bureau of Taxation	Mon.	
1 5" ELM S.W. 36.15' 2 16" ELM N.W. 43.99' 3 MON NORTH 1240' 4 30" ELM N.E. 94.22' (GONE) 5 W.C. SIGN POST S.E. 20.02'(GONE) 6 40" OAK S.E. 115.11' (GONE) 9 DIST = 2594.84' TO L-03 10 DIST = 1598.07 TO S.W. COR., SEC.6, HURON TWP. 11 ANGLE TO R. B.S. L-3, F.S. M-2 = 91-21'50"			
08/24/1978	Ayers	4615	Certificate of Survey Fd. mon. in mon. box
	NO WITNESSES		
12/20/1978	Carlson	14259	Certificate of Survey
	1 P.K. NAIL IN 24" TREE S.W. 35.10' 2 P.K. NAIL IN 24" TREE N.W. 44.00' 7 P.K. NAIL IN POLE N.E. 30.30'		
09/24/1981	Gilmore	16930	Certificate of Survey Fd. 3/4" iron pipe
	NO WITNESSES		
10/04/1981	Gilmore	16930	778
	1 P.K. NAIL N.W. SIDE 18" ELM S50W 36.66' 2 P.K. NAIL S.W. SIDE 24" SWEET GUM N45W 44.83' 12 P.K. NAIL IN S.E. SIDE D.E. POLE S45W 77.53'(GONE) 13 P.K. NAIL IN E. SIDE 16" B. OAK S30E 63.47' (GONE)		FD. 3/4" IRON PIPE
08/21/1991	Blanchard	27446	Certificate of Survey
	NO WITNESSES		

L127794PA305