

**SURVEY &
REMONUMENTATION**

RC 1440

L127794PA306

APR 25 1995

LAND CORNER RECORDATION CERTIFICATE

COMMISSION

Filing Requirement of Act 74, Mich. P.A. 1970

M-05 Page 1

For corners in
Wayne
County

Located in: Sumpter Corner Code

- | | | | |
|---------------------------------------|--------------|--------------|-------------|
| 1. Public Land Survey | T <u>4</u> S | R <u>8</u> E | <u>M-05</u> |
| | T _____ | R _____ | _____ |
| | T _____ | R _____ | _____ |
| | T _____ | R _____ | _____ |
| 2. Property Controlling
In Section | S _____ | T _____ | R _____ |
| | S _____ | T _____ | R _____ |
| 3. Miscellaneous
Property In Sec. | S _____ | T _____ | R _____ |
| | S _____ | T _____ | R _____ |
| 4. Lot No. _____, Recorded Plat _____ | | | |
| 5. Private Claims _____ | | | |

Compliance with
ACT 345, P.A. 1990

APPROVED ON: 12/9/94 TKAO
**WAYNE COUNTY REMONUMENTATION
PEER GROUP COMMITTEE**

Register of Deeds Stamp and File Number

	A	B	C	D	E	F	G	H	I	J	K	L	M
2	6	5	4	3	2	1							
3													
4	7	8	9	10	11	12							
5													
6	18	17	16	15	14	13							
7													
8	19	20	21	22	23	24							
9													
10	30	29	28	27	26	25							
11													
12	31	32	33	34	35	36							
13													

I, Kenneth S. Wilkerson in a field survey on 06/10/1994
do hereby certify that under requirements of P.A. 74, Michigan P.A. of 1970, the corner points mentioned in lines 1 and 2 above were in conformance with regulations and rules therefore as required in the current manual of survey instructions of the United States Department of the Interior, Bureau of Land Management, or by a decree of a Court of Law and/or that the corner points mentioned in lines 3, 4 and 5 above were in conformance with the rules of the Michigan Board of Land Surveyors or by a Decree of a Court of Law, established, re-established, monumented, re-monumented, recovered, found as expressed below.

NOTE: Not more than 4 corners, all in the same town and range, may be recorded on this certificate.

A. Description of original monument and accessories and/or subsequent restorations:

01/01/1930 Wayne Co. Fd. mon.
Bureau of
Taxation

4 W.C.R. SIGN POST N W 36.70' (GONE)
5 16" BUTTERNUT N.W. 97.92' (GONE)

(Witnesses Continued on Back ...)

B. Description of corner evidence found and/or method applied in restoring or reestablishing corner:

Fd. 3/4" iron rod in Mon. box w/ W.C.B.M. cover in asph. pvmt. @ 3'N.&5'W. of int cl's Clark & Judd. Dist. to M-6 = 2710.29'(R), 2710.65'(M) & Dist. to L-5 = 2619.68'(R), 2619.65'(M)

C. Description of monument for corner and accessories established to perpetuate locating the position of the corner:

06/10/1994 Hoben 35994 O.H.M. Remon.


SET W.C.R. WASHIER & CAP OVER CORNER.
8 TOP BOLT ON HYDRANT S 45 W 59.53'
10 W.C.R. TAG ON TOP OF 3rd GRD. RL. PST. fr. N. @N.W. COR. OF IN
11 SET W.C.R. TAG TOP OF FIRST GR POST N33E 63.63
12 BS(M-6 FS) L-5 ANGLE=88-11-15.0 DIST=2619.65' TO L-5
13 TOP BOLT ON HYD. S10E 159.77'

\$ 16.00 MISCELLANEOUS RECORDING
21 DEC 94 3:13 P.M. REGISTERED
STATE OF MICHIGAN
DEPARTMENT OF LAND & WATER
DIVISION OF REGISTERED LAND

We conclude that after careful study of the record documentation and field observations, that this corner is accepted as the best available evidence of the position of the original corner.

Signed by [Signature]
Drafted by Kenneth S. Wilkerson
Surveyor's Michigan License No. 21584

Date DEC 21 1994

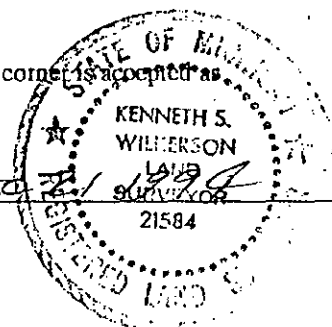

Orchard, Hiltz and McCliment, Inc. 34935 Schoolcraft Road Livonia, MI 48150

ER
12/21/94

A (Continued) Description of original monument and accessories and/or subsequent restorations:

01/01/1816

G.L.O.

SET POST

01/01/1930

Wayne Co.
Bureau of
Taxation

Fd. mon. L127794PA307

- 1 18" OAK S.W. 53.04' (GONE)
- 2 16" CHERRY S.W. 97.22' (GONE)
- 3 TEL. POLE N.W. 57.92' (GONE)
- 6 IRON NORTH 1653'
- 7 TEL. POLE N.E. 38.32' (GONE)

06/16/1970

Johns

W.C.R.C.

Fd. iron

- 1 36" OAK SW 52.82' (GONE)
- 3 M.B.T. POLE NW 58.01' (GONE)
- 7 M.B.T. POLE NE 38.62' (GONE)
- 8 CENTER OF HYD. SW 59.53'
- 9 SET HUB ON FENCE SE 30.63'
- 12 DIST. TO L-05 = 2619.22'
- 13 DIST. TO M-04 = 2665.71'
- 14 DIST. TO M-06 = 2710.29'

02/20/1973

Crossmen

9428

Fd. iron pipe

- 1 NAIL IN SE SIDE 26" OAK S 30 W 53.04' (GONE)
- 3 M.B.T. POLE N 63 W 57.92' (GONE)
- 7 NAIL NW SIDE M.B.T. POLE N 40 E 42.61' (GONE)
- 8 CENTER HYD. S 55 W 59.55'