

SURVEY & REMONUMENTATION

APR 25 1995

RC 1441

L127794PA308

COMMISSION

LAND CORNER RECORDATION CERTIFICATE

Filing Requirement of Act 74, Mich. P.A. 1970

M-07 Page 1

For corners in

Wayne

County

Located In: Sumpter Corner Code

1. Public Land Survey	T 4 S R 8 E	M-07
	T _____ R _____	_____
	T _____ R _____	_____
	T _____ R _____	_____
2. Property Controlling in Section	S _____ T _____ R _____	_____
	S _____ T _____ R _____	_____
3. Miscellaneous Property in Sec.	S _____ T _____ R _____	_____
	S _____ T _____ R _____	_____

Compliance with ACT 345, P.A. 1990

APPROVED ON: 12/9/94 WCA
WAYNE COUNTY REMONUMENTATION PEER GROUP COMMITTEE

Register of Deeds Stamp and File Number

4. Lot No. _____, Recorded Plat _____
5. Private Claims _____

	A	B	C	D	E	F	G	H	I	J	K	L	M
2	6	5	4	3	2	1							
3													
4	7	8	9	10	11	12							
5													
6	18	17	16	15	14	13							
7													
8	19	20	21	22	23	24							
9													
10	30	29	28	27	26	25							
11													
12	31	32	33	34	35	36							
13													

I, Kenneth S. Wilkerson in a field survey on 06/10/1994 do hereby certify that under requirements of P.A. 74, Michigan P.A. of 1970, the corner points mentioned in lines 1 and 2 above were in conformance with regulations and rules therefore as required in the current manual of survey instructions of the United States Department of the Interior, Bureau of Land Management, or by a decree of a Court of Law and/or that the corner points mentioned in lines 3, 4 and 5 above were in conformance with the rules of the Michigan Board of Land Surveyors or by a Decree of a Court of Law, established, re-established, monumented, re-monumented, recovered, found as expressed below.

NOTE: Not more than 4 corners, all in the same town and range, may be recorded on this certificate.

A. Description of original monument and accessories and/or subsequent restorations:

01/01/1819 Wampler G.L.O. Set post
18" LIME S 12 E 23 LINKS (15.18') (GONE)
30" W. OAK N 56 W 24 LINKS (15.84') (GONE)

(Witnesses Continued on Back ...)

B. Description of corner evidence found and/or method applied in restoring or reestablishing corner:

Fd. 1" iron pipe in gravel rd. 3" below surface @ cl of Clark Rd. Dist. to M-6 = 2671.70' (R), 2671.98' (M) & Dist to M-8 = 2688.86' (R), 2688.79' (M)

C. Description of monument for corner and accessories established to perpetuate locating the position of the corner:

06/10/1994 Wilkerson 21584 O.H.M. Remon.


SET W.C.R. WASHER & CAP OVER CORNER.
THIS IS NOT A COMMON CORNER WITH A-7, HURON TWP.
8 TOP BOLT ON HYDRANT N.65 E 33.33'
9 W.C.R. TAG N.W./S P.P. S 17 W 137.78'
13 ANGLE TO R. B.S. M-6, F.S. M-8 = 180-01'20"

\$ 16.00 MISCELLANEOUS RECORDING
21 DEC 94 3:13 P.M. REGISTERED DEEDS
JAMES E. YOUNG, JR. REGISTER OF DEEDS

We conclude that after careful study of the record documentation and field observations, that this corner is accepted as the best available evidence of the position of the original corner.

Signed by [Signature]
Drafted by Kenneth S. Wilkerson
Surveyor's Michigan License No. 21584

Date Dec 21 1994

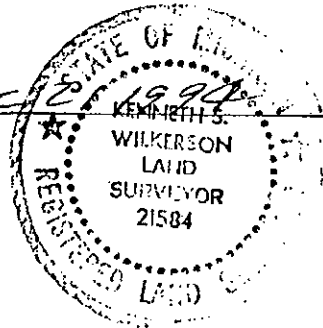

Orchard, Hiltz and McCliment, Inc. 34935 Schoolcraft Road Livonia, MI 48150

Z R
14 M - Misc.

A (Continued) Description of original monument and accessories and/or subsequent restorations:

01/01/1930

Wayne Co.
Bureau of
Taxation

Set iron

- 1 12" HICKORY S.E. 163.05' (GONE)
- 2 5" ELM SW 113.32' (GONE)
- 3 ED. POLE N.W. 34.60' (GONE)
- 4 F.P. N.W. 41.25' (GONE)
- 5 7" ELM N.W. 110.58' (GONE)
- 6 STONE TO THE NORTH 1835'
- 7 FENCE TO THE EAST 25.95' (GONE)
- 11 DIST = 2671.70' TO M-06
- 12 DIST = 2688.86' TO M-08
- 13 ANGLE TO R. B.S. M-6, F.S. M-8 = 179-59'31"

L127794PA309

06/24/1970

Johns

W.C.R.C.

Fd. iron

- 1 24" HICKORY S.E. 162.74' (GONE)
- 3 ED. POLE S.W. 34.15' (GONE)

01/01/1976

D.E.

NO WITNESSES

06/07/1979

Arthurs

11358

Fd. iron pipe

NO WITNESSES