

SURVEY &
REMONUMENTATION

RC 1442

LI27794PA310

APR 25 1995

LAND CORNER RECORDATION CERTIFICATE

Filing Requirement of Act 74, Mich. P.A. 1970

M-09 Page 1

For corners in **COMMISSION**

Wayne	Located in:	Sumpter	Corner Code
County			
1. Public Land Survey	T <u>4</u> S	R <u>8</u> E	M-09
	T _____	R _____	_____
	T _____	R _____	_____
	T _____	R _____	_____
2. Property Controlling In Section	S _____	T _____	R _____
	S _____	T _____	R _____
3. Miscellaneous Property in Sec.	S _____	T _____	R _____
	S _____	T _____	R _____
4. Lot No. _____, Recorded Plat _____			
5. Private Claims _____			

Compliance with
ACT 345, P.A. 1990
APPROVED ON: 12/9/94 ncd
WAYNE COUNTY REMONUMENTATION
PEER GROUP COMMITTEE

Register of Deeds Stamp and File Number

	A	B	C	D	E	F	G	H	I	J	K	L	M
2	8	5	4	3	2	1							
3													
4	7	8	9	10	11	12							
5													
6	18	17	16	15	14	13							
7													
8	19	20	21	22	23	24							
9													
10	30	29	28	27	26	25							
11													
12	31	32	33	34	35	36							
13													

I, Kenneth S. Wilkerson in a field survey on 06/06/1994
do hereby certify that under requirements of P.A. 74, Michigan P.A. of 1970, the corner points mentioned in lines 1 and 2 above were in conformance with regulations and rules therefore as required in the current manual of survey instructions of the United States Department of the Interior, Bureau of Land Management. or by a decree of a Court of Law and/or that the corner points mentioned in lines 3, 4 and 5 above were in conformance with the rules of the Michigan Board of Land Surveyors or by a Decree of a Court of Law, established, re-established, monumented, re-monumented, recovered, found as expressed below.

NOTE: Not more than 4 corners, all in the same town and range, may be recorded on this certificate.

A. Description of original monument and accessories and/or subsequent restorations:
01/01/1819 Wampler G.L.O. Set post
6" HICKORY N 44 W 33 LINKS (21.78') (GONE)
24" ELM S 44 E 31 LINKS (20.46') (GONE)

(Witnesses Continued on Back ...)

B. Description of corner evidence found and/or method applied in restoring or reestablishing corner:
Fd. capped iron in mon. box (no lid) in asph. pvm't. @ int. of cl's of Willow & Clark Rds. Dist to L-9 = 2645.00' (R), 2643.24' (M) & Dist. to M-8 = 2671.83 (R), 2671.72 (M)


C. Description of monument for corner and accessories established to perpetuate localing the position of the corner:
06/06/1994 Wilkerson 21584 O.H.M. Remon.
SET W.C.R. WASHER & CAP OVER CORNER.
THIS IS NOT A COMMON CORNER WITH A-9 HURON TWP..
7 W.C.R. TAG N.E./S P.P. N 60 W 70.65'
10 W.C.R. TAG N.W./S P.P. S 40 E 44.89'
11 W.C.R. TAG S.W./S P.P. S 17 W 52.14'
14 ANGLE TO RIGHT B.S. L-9 = 90-41'35"

\$ 16.00 MISCELLANEOUS RECORDING
21 DEC 94 3:20 P.M. RECORDED
LIBRARY OF THE REGISTER OF DEEDS

We conclude that after careful study of the record documentation and field observations, that this corner is accepted as the best available evidence of the position of the original corner.

Signed by [Signature]
Drafted by Kenneth S. Wilkerson
Surveyor's Michigan License No. 21584

Date Dec 21 1994

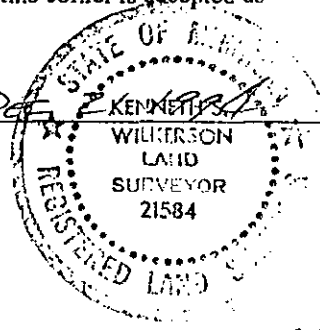

Orchard, Hiltz and McCliment, Inc. 34935 Schoolcraft Road Livonia, MI 48150

Z R
14 N - 1030

A (Continued) Description of original monument and accessories and/or subsequent restorations:

01/01/1930

Wayne Co.
Bureau of
Taxation

Iron

LI27794PA311

- 1 ED. POLE S.W. 50.92' (GONE)
- 2 24" MAPLE S.W. 114.63' (GONE)
- 3 7" ELM N.W. 72.70' (GONE)
- 4 STONE NORTH 1914'
- 5 CROSS IN W.C.R. SIGN N.E. 44.92' (GONE)
- 12 DIST = 2645.00' TO L-09
- 13 DIST = 2671.83' TO M-08
- 14 ANGLE TO R. B.S. L-9 = 90-41'37"

06/25/1974

Johns

W.C.R.C.

Iron in box

- 6 DE POLE S.W. 49.85' (GONE)
- 7 M.B.T. POLE N.W. 70.63'
- 8 DE POLE N.W. 112.03' (GONE)
- 9 WOOD POST N.E. 42.80' (GONE)
- 10 GUY POLE S.E. 45.07'

08/08/1985

Pitts

10702

R.C.8

Fd. 3/4" iron in mon. box

- 6 NAIL IN BRASS TAG SW SIDE OF UP S.W. 49.89' (GONE)
- 7 NAIL IN BRASS TAG NE SIDE OF M.B.T. POLE N.W. 70.7
- 10 NAIL IN BRASS TAG NE SIDE OF GUY POLE S.E. 44.93'