

**SURVEY &
REMONUMENTATION**

RC 1443

L127794PA312

APR 25 1995

LAND CORNER RECORDATION CERTIFICATE

COMMISSION

Filing Requirement of Act 74, Mich. P.A. 1970

M-11 Page 1

For corners in

Wayne

Located in: Sumpter Corner Code

County

1. Public Land Survey	T <u>4</u> S R <u>8</u> E	<u>M-11</u>
	T _____ R _____	_____
	T _____ R _____	_____
	T _____ R _____	_____
2. Property Controlling In Section	S _____ T _____ R _____	_____
	S _____ T _____ R _____	_____
3. Miscellaneous Property in Sec.	S _____ T _____ R _____	_____
	S _____ T _____ R _____	_____
4. Lot No. _____, Recorded Plat _____		
5. Private Claims _____		

Compliance with
ACT 345, P.A. 1990

APPROVED ON: 12/9/94 TC/D
WAYNE COUNTY REMONUMENTATION
PEER GROUP COMMITTEE

Register of Deeds Stamp and File Number

I, Kenneth S. Wilkerson in a field survey on 06/06/1994
do hereby certify that under requirements of P.A. 74, Michigan P.A. of 1970, the corner points mentioned in lines 1 and 2 above were in conformance with regulations and rules therefore as required in the current manual of survey instructions of the United States Department of the Interior, Bureau of Land Management, or by a decree of a Court of Law and/or that the corner points mentioned in lines 3, 4 and 5 above were in conformance with the rules of the Michigan Board of Land Surveyors or by a Decree of a Court of Law, established, re-established, monumented, re-monumented, recovered, found as expressed below.

NOTE: Not more than 4 corners, all in the same town and range, may be recorded on this certificate.

A. Description of original monument and accessories and/or subsequent restorations:

01/01/1819 Alex Holems G.L.O. Set post
15" SUGAR S 55 E 27 LINKS (17.82') (GONE)
18" MAPLE S 16 W 13 LINKS (8.58') (GONE)

(Witnesses Continued on Back ...)

B. Description of corner evidence found and/or method applied in restoring or reestablishing corner:

Fd. 5/8" rod in gravel rd 11" below surface @ 6'w. of int. of cl's of Clark & Arkona Rds. Dist to M-10 = 2672.22' (R) & 2671.72' (M)

C. Description of monument for corner and accessories established to perpetuate locating the position of the corner:

06/06/1994 Wilkerson 35994 O.H.M. Remon.


- SET W.C.R. WASHER & CAP OVER CORNER.
- 2 CROSS IN CONC. CULV. N 41 W 22.99'
- 8 TOP BOLT ON HYDRANT S 30 E 66.50'
- 10 B.M. #60-254 S 50 W 47.51'
- 18 P.K. NAIL N SIDE 16" OAK S10E 115.80'

\$ 16.00 MISCELLANEOUS RECORDING
21 DEC 94 3:18 P.M. 1994
OFFICE OF THE REGISTER OF DEEDS

We conclude that after careful study of the record documentation and field observations, that this corner is accepted as the best available evidence of the position of the original corner.

Signed by: [Signature]
Drafted by Kenneth S. Wilkerson
Surveyor's Michigan License No. 21584

Date 12/9/94

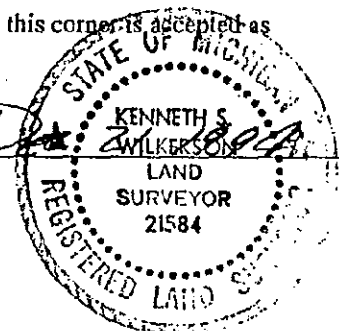

Orchard, Hiltz and McCliment, Inc. 34935 Schoolcraft Road Livonia, MI 48150

2 R
14 N - Misc

A. (Continued) Description of original monument and accessories and/or subsequent restorations:

01/01/1930	Wayne Co. Bureau of Taxation	Iron	L127794PA313
1	W.C.R. SIGN POST N.W. 38.01' (GONE)		
2	CROSS IN CONC. CUL. N.W. 22.50'		
3	8" ELM N.E. 46.65' (GONE)		
4	STONE NORTH 2031'		
5	12" THORN APPLE S.E. 34.85' (GONE)		
6	8" ELM S.E. 80.50' (GONE)		
7	CROSS IN CONC. CUL. S.W. 29.51' (GONE)		
12	DIST = 2672.22' TO M-12		
01/01/1967	B & S D.E.	Set 3/8" re-rod	
2	CROSS IN CONC. CUL. N.W. 22.50'		
3	8" ELM N.E. 46.65' (GONE)		
5	12" THORN APPLE S.E. 34.85' (GONE)		
7	CROSS IN CONC. CUL. S.W. 29.51' (GONE)		
06/04/1974	Roskelly	Survey	Iron bar
8	F. HYD. S 30 E 69.35'		
9	NAIL IN 15" OAK S 15 E 50.20' (GONE)		
10	B.M. #60-254 S 50 W 53.2'		
11	STOP SIGN S 60 W 41.16' (GONE)		
06/23/1978	Arthurs 11358	Survey	
	NO WITNESSES		
01/20/1992	McCneely & Lincoln	survey	Fd. 1/2" iron
15	FD. P.K. S.W. SIDE OF 16" TREE S50E 30.7'		
16	FD. P.K. TOP OF GR POST S28W 31.2'		
17	SET P.K. TOP OF GR POST N45W 21.7'		