

LAND CORNER RECORDATION CERTIFICATE

Filing Requirement of Act 74, Mich. P.A. 1970

M-12 Page 1

For corners in

Wayne

Located in: Sumpter Corner Code

County

1. Public Land Survey		T <u>4</u> S	R <u>8</u> E	<u>M-12</u>
		T _____	R _____	_____
		T _____	R _____	_____
		T _____	R _____	_____
2. Property Controlling in Section	S _____	T _____	R _____	_____
	S _____	T _____	R _____	_____
3. Miscellaneous Property in Sec.	S _____	T _____	R _____	_____
	S _____	T _____	R _____	_____

L129366PA899

Compliance with ACT 345, P.A. 1990

APPROVED ON: 12-16-96
WAYNE COUNTY REMONUMENTATION PEER GROUP COMMITTEE

Register of Deeds Stamp and File Number

4. Lot No. _____, Recorded Plat _____
 5. Private Claims _____

	A	B	C	D	E	F	G	H	I	J	K	L	M
2	6	5	4	3	2	1							
3													
4	7	8	9	10	11	12							
5													
6	18	17	16	15	14	13							
7													
8	19	20	21	22	23	24							
9													
10	30	29	28	27	26	25							
11													
12	31	32	33	34	35	36							
13													

I, Kenneth S. Wilkerson in a field survey on 02/22/1996 do hereby certify that under requirements of P.A. 74, Michigan P.A. of 1970, the corner points mentioned in lines 1 and 2 above were in conformance with regulations and rules therefore as required in the current manual of survey instructions of the United States Department of the Interior, Bureau of Land Management, or by a decree of a Court of Law and/or that the corner points mentioned in lines 3, 4 and 5 above were in conformance with the rules of the Michigan Board of Land Surveyors or by a Decree of a Court of Law, established, re-established, monumented, re-monumented, recovered, found as expressed below.

NOTE: Not more than 4 corners, all in the same town and range, may be recorded on this certificate.

A. Description of original monument and accessories and/or subsequent restorations:
 12/07/1815 Wampler G.L.O. Set post
 20" DO. N. 37 LINKS W. 51 LINKS (GONE)
 24" MAPLE S. 34 LINKS E. 16 LINKS (GONE)

(Witnesses Continued on Back ...)

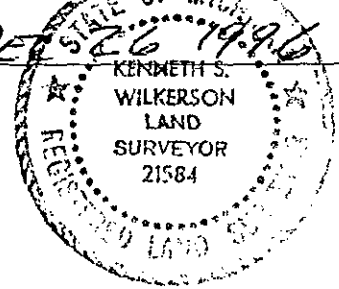
B. Description of corner evidence found and/or method applied in restoring or reestablishing corner:
 Fd. 1" iron pipe in center of gravel road (Clark) 6" deep dist to M-13 = 2678.59'(R) 2678.69'(M) and dist to M-11 = 2672.22'(R) 2671.72'(M)

C. Description of monument for corner and accessories established to perpetuate locating the position of the corner:
 02/22/1996 Wilkerson 21584 O.H.M. Remon.
 SET W.C.R. CAP AND WASHER OVER FD. 1" I.P.
 NOT A COMMON CORNER
 18 S23E 73.28' TO TOP BOLT ON HYD.
 19 S50W 43.88' TO P.K. NAIL IN SE SIDE OF 20" TWIN OAK.
 20 S88W 28.61' TO NAIL AND W.C. REMON TAG IN S. SIDE 11" TWIN OAK.
 21 N59W 39.17' P.K. NAIL IN NE SIDE OF 12" CHERRY.
 22 SOUTH 567.31' TO S.W. COR OF SEC.31 IN HURON TWP.

\$ 10.00 DEED
 30 DEC 96 1:38 P.M. RECEIPT# 44B
 RECORDED
 FOREST E. YOUNGBLOOD, REGISTER OF DEEDS
 WAYNE COUNTY, MI
 \$ 4.00 REMONUMENTATION

We conclude that after careful study of the record documentation and field observations, that this corner is accepted as the best available evidence of the position of the original corner.

Signed by [Signature]
 Drafted by Kenneth S. Wilkerson
 Surveyor's Michigan License No. 21584
 Orchard, Hiltz and McCliment, Inc. 34935 Schoolcraft Road Livonia, MI 48150

Date DEC 26 1996

 4R
 100
 JBJ

A. (Continued) Description of original monument and accessories and/or subsequent restorations:

01/01/1930		W.C. B/T	Iron
1	6" ASH SE. 50.42' (GONE)		
2	5" ELM SW. 75.04' (GONE)		
5	3" ELM W. 31.85' (GONE)		
6	4" ELM NW. 45.55' (GONE)		
06/01/1970		W.C.R.C.	Iron
7	BELL PULE NE 56.37' (GONE)		
8	12" ASH SE 50.42' (GONE)		
9	12" TWIN ELM SW 75.04' (GONE)		
10	6" ELM W 31.85' (GONE)		
11	12" ELM NW 45.55' (GONE)		
06/24/1970	Johns	W.C.R.C.	Iron
7	M.B.T. POLE NE 56.50' (GONE)		
9	TWIN 12" ASH SW 43.35' (GONE)		
12	M.B.T. POLE SE 124.75' (GONE)		
13	TWIN 6" HICHORY 34.82' (GONE)		
05/02/1980	Young	W.C.R.C.	
14	M.B.T. NE 81.72' (GONE)		
15	CENTER OF HYD. NE 79.57' (GONE)		
16	D.E. POLE SE 65.71' (GONE)		
17	D.E. POLE SW 80.00' (GONE)		

LI29366PA900