

APR 05 1996

LAND CORNER RECORDATION CERTIFICATE
Filing Requirement of Act 74, Mich. P.A. 1970


LIBER 28451 PAGE 492

For corners in **COMMISSION**

<u>Wayne Co.</u> (County)	Located in: Twp. of Huron	Corner Code #
1. Public Land Survey	T <u>4 S</u> R <u>9 E</u>	<u>A-11</u>
	T _____ R _____	_____
	T _____ R _____	_____
	T _____ R _____	_____
2. Property Controlling in Section	S _____ T _____ R _____	_____
	S _____ T _____ R _____	_____
3. Miscellaneous Property in Sec.	S _____ T _____ R _____	_____
	S _____ T _____ R _____	_____
4. Lot No. _____, Recorded Plat _____		
5. Private Claims _____		

Compliance with
ACT 345, P.A. 1990
APPROVED ON: 11-28-95 *R.J.*
**WAYNE COUNTY REMONUMENTATION
PEER GROUP COMMITTEE**
Register of Deeds Stamp & File Number

I, Randy Kolehouse, in a field survey on Nov. 3 1995, do hereby certify that under requirements of P.A. 74 Michigan P.A. of 1970, the corner points mentioned in lines 1 and 2 above were in conformance with regulations and rules therefore as required in the current manual of survey instructions of the United States Department of the Interior, Bureau of Land Management or by a decree of a Court of Law and/or that the corner points mentioned in lines 3, 4 and 5 above were in conformance with the rules of the Michigan Board of Land Surveyors or by a Decree of a Court of Law; established, re-established, monumented, re-monumented, recovered, found as expressed below:

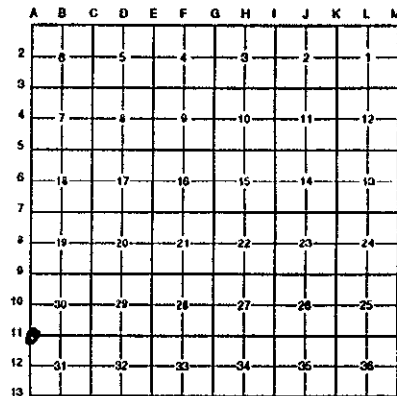

NOTE: Not more than 4 corners, all in the same town and range, may be recorded on this certificate.

A. Description of original monument and accessories and/or subsequent restoration:

A-11	1815	GLO	Hoolmy	Notes	Post
	1930's	WPA	Unknown	Section map and ties	Stone
	1967	D.E.Co.		Notes	1/2" solid iron
	1973	W.C.R.C.		Section ties	Stone with 1/2" rerod 3"+/- S.W.
	1976	Cert. Survey	Richard #13040	L.19543,P.640	l. rod
	1976	L.C.R.C.	Richard #13040	L.19543,P.641	1/2" Iron rod 7.00 DEED
	1977	Cert. Survey	Wilkerson #21584	L.19684,P.394	Not stated \$ 4.00. REMONUMENTATION
	1988	L.C.R.C./ Survey	Stephens #29252	L.24088,P.284	Iron bar 8 DEC 95 12:36 P.M. RECEIP

Note: This corner is not common with M-11 T4S, R8E.

RECORDED
FOREST E. YOUNGBLOOD, REGISTER
WAYNE COUNTY, MI

B. Description of corner evidence found and/or method applied in restoring or reestablishing corner:

A-11 I found a stone with a 1/2" rebar on the west edge of the stone, at the centerline of Ash Rd. (gravel) and 6' west of the centerline of Clark Rd. (gravel.). Which agrees with the following:

- | | |
|-------------------------------------|--|
| D.E. Co. notes 1967 | L.C.R.C. / Cert. Survey L.19543,P.640/641 |
| D.E. pole S50°W 84.00' | D.E. pole S45°W 84.05' |
| | WCRC tag in 24" Box Elder N70°W 59.52' |
| Cert. Survey L.19684,P.394 | L.C.R.C. L.24088,P.284 |
| Nail in pole S45°W 84.06' | Nail & WCRC tag in NW face D.E. pole S45° W 84.00' |
| Nail in 24" Box Elder N70° W 59.52' | Nail in s. face 24" Box Elder N70° W 59.42' |
- Measures east to B-11 T4S,R9E = 2708.51' (GLO = 2706'),(WPA =2707.21"sec.30,2707.75"sec.31),(LCRC L.24088,P.284=2708.22')
Measures south to A-12 T4S,R9E = 2634.87' (WPA =2634.32'),(D.E.Co.1967=2634.57'),(LCRC L.24088,P.284=2634.54')
Measures south to M-11 T4S,R8E = 2029.98' (GLO = 2026.20'),(WPA =2031'+/-)


C. Description of monument for corner and accessories established to perpetuate locating the position of the corner:

A-11 I replaced stone and rebar with a 2" aluminum cap stamped "Wayne County Remonumentation #25854" on a concrete monument.

Nail w/ W.C.R.C. tag in NW face p. pole	S56°W	83.90'
PK Nail in S. face 30" Box Elder	N64°W	59.00'
C.L. Stop sign post	N74°E	51.94'
PK Nail in N face p. pole	S72°E	265.42'

The selected location is accepted by the Contractor and is generally accepted by professional surveyors as the best available evidence of the position of the original corner.

Signed by Randy J. Kolehouse Date 12/2/95
Surveyor's Michigan License No. 25854

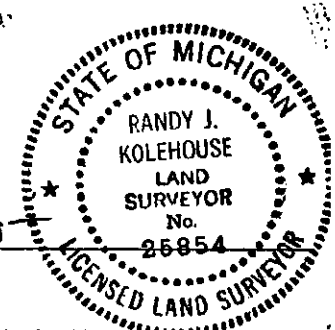

45262447