

SURVEY & REMONUMENTATION

RC 1582

\$ 13.00 MISCELLANEOUS RECORDING

APR 25 1995

LAND CORNER RECORDATION CERTIFICATE
Filing Requirement of Act 74, Mich. P.A. 1970

LI27800PA649

COMMISSION

For corners in

<u>WAYNE</u> (County)	Located in: Huron Township	Corner Code #
1. Public Land Survey	T <u>4S</u> R <u>9E</u>	<u>B-5</u>
	T _____ R _____	_____
	T _____ R _____	_____
	T _____ R _____	_____
2. Property Controlling In Section	S _____ T _____ R _____	_____
	S _____ T _____ R _____	_____
3. Miscellaneous Property in Sec.	S _____ T _____ R _____	_____
	S _____ T _____ R _____	_____

\$ 13.00 MISCELLANEOUS RECORDING
28 DEC 94 9:38 A.M. RECEIPT# 169
RECORDED
FOREST E. YOUNG, REG. REGISTER OF DEEDS
Compliance with
ACT 345, P.A. 1990
APPROVED ON: 12-7-94 *[Signature]*
WAYNE COUNTY REMONUMENTATION
PEER GROUP COMMITTEE

Register of Deeds Stamp & File Number

4. Lot No. _____, Recorded Plat _____
5. Private Claims _____

I, Randy Kolehouse, in a field survey on October 19 19 94, do hereby certify that under requirements of P.A. 74 Michigan P.A. of 1970, the corner points mentioned in lines 1 and 2 above were in conformance with regulations and rules therefore as required in the current manual of survey instructions of the United States Department of the Interior, Bureau of Land Management or by a decree of a Court of Law and/or that the corner points mentioned in lines 3, 4 and 5 above were in conformance with the rules of the Michigan Board of Land Surveyors or by a Decree of a Court of Law; established, re-established, monumented, re-monumented, recovered, found as expressed below:

NOTE: Not more than 4 corners, all in the same town and range, may be recorded on this certificate.

A	B	C	D	E	F	G	H	I	J	K	L	M
2	6	5	4	3	2	1						
3												
4	7	8	9	10	11	12						
5	•											
6	16	17	16	15	14	13						
7												
8	19	20	21	22	23	24						
9												
10	30	29	28	27	26	25						
11												
12	31	32	33	34	35	36						
13												

A. Description of original monument and accessories and/or subsequent restoration:

B-5	1817	G.L.O. Notes	N/A	Post
	1930's	WPA Notes	N/A	Iron
	1973	WCRC Notes	N/A	3/4" Iron Level w/Top of A.C.
	1973	Cert. Survey L. 18158 P. 196 & Cert. Survey L. 18725 P. 434	N/A	1/2" Iron Pipe
	1974	L.C.R.C. L. 18965 P. 341	Crossman	Iron Pipe

RC 1582

B. Description of corner evidence found and/or method applied in restoring or reestablishing corner:

B-5 I found 1/2" pipe in a monument box at the C/L intersection of Judd (asphalt) running E-W and Otter Road (gravel) running South which agrees with the following witnesses.

L.C.R.C. L. 18965 P. 341
Nail & Cap NE Side Tel. Pole S 60° E 75.01' (74.98' m)
Nail & Cap NW Side Tel. Pole S 50° W 51.85' (51.85' m)

Cert. Survey L. 18158 P. 196 & L. 18725 P. 434
D.E. Pole S 57° W 52.00' (51.85' m)


WCRC 1973
Nail & Tag (WCRC) NE Side MBT Pole SE'ly 75.03' (74.89' m)
Nail & Tag (WCRC) NW Side MBT Pole SW'ly 51.87' (51.85' m)
Nail & Tag (WCRC) NE Side MBT Pole NW'ly 100.80' (100.75' m)

Measures West to A-5 = 2717.63' (G.L.O. = 2710.62') (WPA = 2716.67')
Measures East to C-5 = 2615.69' (G.L.O. = 2690') (WPA = 2615.04' S-7 and 2615.34' S-18)

C. Description of monument for corner and accessories established to perpetuate locating the position of the corner:

B-5 I replaced the 1/2" pipe with 1/2" iron rod w/aluminum cap stamped "Wayne Co. Remon."

P.K. S Face Guardrail Post East End Guardrail N 56° E 32.20'
Nail w/Tag "WCRC" NE Face Util. Pole S 65° E 74.98'
Nail w/Tag "WCRC" NW Face Util. Pole S 62° W 51.85'
P.K. S Face Guardrail Post West End Guardrail N 50° W 29.54'

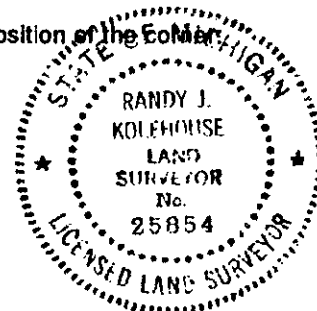

2 R
11-D
misc

The selected location is accepted by the Contractor and is generally accepted by professional surveyors as the best available evidence of the position of the original corner.

Signed by Randy J. Kolehouse Date 12/14/94
Surveyor's Michigan License No. 25854