

APR 05 1996

COMMISSION

LAND CORNER RECORDATION CERTIFICATE
Filing Requirement of Act 74, Mich. P.A. 1970

\$ 4.00 REMONUMENTATION
\$ 7.00 DEED
8 DEC 95 12:36 P.M. RECEIP
RECORDED

For corners in

Wayne Co. (County)	Located in: Twp. of Huron	Corner Code #
1. Public Land Survey	T 4 S R 9 E	B-11
	T _____ R _____	_____
	T _____ R _____	_____
	T _____ R _____	_____
2. Property Controlling in Section	S _____ T _____ R _____	_____
	S _____ T _____ R _____	_____
3. Miscellaneous Property in Sec.	S _____ T _____ R _____	_____
	S _____ T _____ R _____	_____

FOREST E. YOUNGBLOOD, REGISTER
WAYNE COUNTY, MI

LIBER 28451 PAGE 493


Compliance with
ACT 345, P.A. 1990

APPROVED ON: 11-28-95 *B.J.*
WAYNE COUNTY REMONUMENTATION
PEER GROUP COMMITTEE

Register of Deeds Stamp & File Number

4. Lot No. _____, Recorded Plat _____
5. Private Claims _____

I, Randy Kolehouse, in a field survey on Nov. 1 1995, do hereby certify that under requirements of P.A. 74 Michigan P.A. of 1970, the corner points mentioned in lines 1 and 2 above were in conformance with regulations and rules therefore as required in the current manual of survey instructions of the United States Department of the Interior, Bureau of Land Management or by a decree of a Court of Law and/or that the corner points mentioned in lines 3, 4 and 5 above were in conformance with the rules of the Michigan Board of Land Surveyors or by a Decree of a Court of Law; established, re-established, monumented, re-monumented, recovered, found as expressed below:

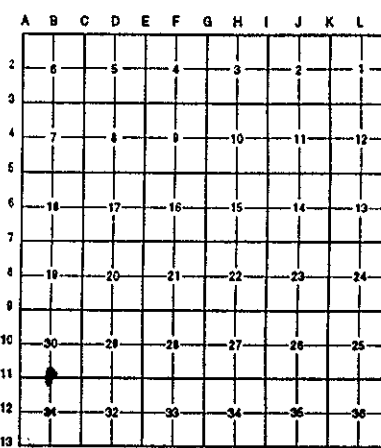

NOTE: Not more than 4 corners, all in the same town and range, may be recorded on this certificate.

A. Description of original monument and accessories and/or subsequent restoration:

B-11	1815	GLO	Hoolmy	Notes	Post
	1930's	WPA	Unknown	Section map and ties	Iron over stone
	1967	D.E.Co.		Notes	1" dia. Iron
	1973	W.C.R.C		Notes	3/4" Iron
	1976	L.C.R.C./Cert. Survey	Richard #13040	L.19543,P.640/641	Iron pin
	1977	Cert. Survey	Wilkerson #21584	L.19684,P.394	Not stated
	1988	L.C.R.C./Survey	Stephens #29252	L.24088,P.284	1" dia. pipe
	1978	W.C.R.C		Notes	Monument

B. Description of corner evidence found and/or method applied in restoring or reestablishing corner:

B-11 I found a 1" ID pipe, 8' south of the centerline of Ash Rd.(gravel.). Which agrees with the following:

- W.C.R.C. 1973 Cert. Survey L.19543,P.640/641
Nail & tag SE face 24" Sycamore NE 41.03' W.C.R.C. tag & nail in 24" Sycamore N40°E 41.69'
C.L. of hyd. SE 42.25'
- L.C.R.C./ Survey L.24088,P.284
Nail w/W.C.R.C. tag SE side 22" Sycamore N40°E 40.72'
PK nail SW side 8" Elm N70°W 60.46'


Measures east to C-11 T4S,R9E = 2629.75' (GLO = 2640'),(WPA =2629.26'sec30,2630.51'sec31)
Measures west to A-11 T4S,R9E = 2708.51' (GLO =2706'),(WPA =2707.21'sec30,2707.75'sec31),(L.C.R.C. L.24088,P.284 =2708.22')

C. Description of monument for corner and accessories established to perpetuate locating the position of the corner:

B-11 I replaced 1" pipe with a 2" aluminum cap stamped "Wayne County Remonumentation #25854" on a concrete monument

- Nail w/ W.C.R.C. tag in SW face 24" Sycamore N45°E 41.69'
- Top nut fire hydrant S52°W 41.63'
- Nail N face 10" Elm S67°E 50.36'
- Nail in S face twin 12" Elm N58°W 60.72'

The selected location is accepted by the Contractor and is generally accepted by professional surveyors as the best available evidence of the position of the original corner.

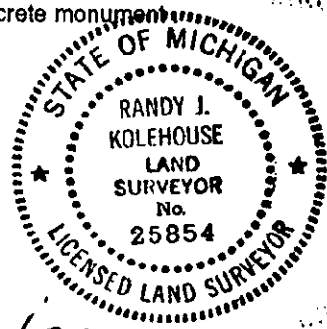

Signed by Randy J. Kolehouse Date 12/2/95
Surveyor's Michigan License No. 25854