

APR 05 1996

LAND CORNER RECORDATION CERTIFICATE
Filing Requirement of Act 74, Mich. P.A. 1970

For corners in

COMMISSION

Wayne (County)	Located in: Huron Township	Corner Code #
1. Public Land Survey	T <u>4S</u> R <u>9E</u>	<u>C-13</u>
	T _____ R _____	_____
	T _____ R _____	_____
	T _____ R _____	_____
2. Property Controlling in Section	S _____ T _____ R _____	_____
	S _____ T _____ R _____	_____
3. Miscellaneous Property in Sec.	S _____ T _____ R _____	_____
	S _____ T _____ R _____	_____

LIBER 28451 PAGE 494

Compliance with
ACT 345, P.A. 1990


APPROVED ON: 11-28-95 *R.J.*
WAYNE COUNTY REMONUMENTATION
PEER GROUP COMMITTEE

Register of Deeds Stamp & File Number

- 4. Lot No. _____, Recorded Plat _____
- 5. Private Claims _____

I, Randy Kolehouse, in a field survey on September 8 19 94, do hereby certify that under requirements of P.A. 74 Michigan P.A. of 1970, the corner points mentioned in lines 1 and 2 above were in conformance with regulations and rules therefore as required in the current manual of survey instructions of the United States Department of the interior, Bureau of Land Management or by a decree of a Court of Law and/or that the corner points mentioned in lines 3, 4 and 5 above were in conformance with the rules of the Michigan Board of Land Surveyors or by a Decree of a Court of Law; established, re-established, monumented, re-monumented, recovered, found as expressed below:

NOTE: Not more than 4 corners, all in the same town and range, may be recorded on this certificate.

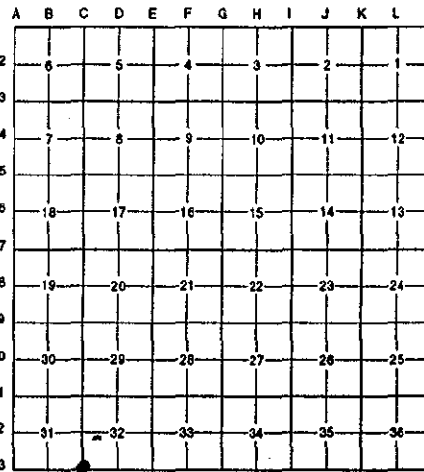

A. Description of original monument and accessories and/or subsequent restoration:

C-13	1817	G.L.O. Notes	N/A	Post
	1930's	WPA Notes	N/A	Iron
	1974	WCRC Notes	N/A	Mon. Box - No Cover & No Mon. Used C/L Box

B. Description of corner evidence found and/or method applied in restoring or reestablishing corner:

C-13 I found an empty monument box 10" ± below surface and a P.K. in C/L of Will Carleton Road (asphalt) running E-W 75.3' West of the C/L of Maxwell Road running South which agrees with the following witnesses.

WPA Witnesses	WCRC
Monument East 75.33'	20" Oak NE 70.30'
	13" Oak NW 37.50'

\$ 4.00 REMONUMENTATION
 \$ 7.00 DEED
 8 DEC 95 12:36 P.M. RECEIP
 RECORDED
 FOREST E. YOUNGBLOOD, REGISTER EDS
 WAYNE COUNTY, MI


Measures West to B-13 = 2677.26' (G.L.O. = 2640') (WPA = 2677.59')
Measures East to E-13 = 5269.04' (G.L.O. = 5280') (WPA = 5269.23')

C. Description of monument for corner and accessories established to perpetuate locating the position of the corner:

C-13 I replaced the P.K. with a 1/2" iron rod with aluminum cap stamped "Wayne Co. Remon." in new monument box.

- Nail w/Tag "WCR" NW Face 40" Twin Oak N 65° E 70.69'
- 1/2" rebar C/L C/L Willcarleton & Maxwell East 75.34'
- Nail w/Cap in E Face 15" Oak S 31° W 36.79'
- Nail w/Tag "WCR" NE Face 24" Oak N 20° W 37.70'

NOT A COMMON
CORNER

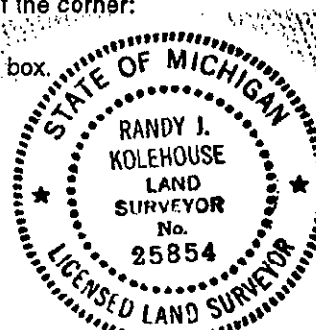

The selected location is accepted by the Contractor and is generally accepted by professional surveyors as the best available evidence of the position of the original corner.

Signed by Randy Kolehouse Date 12/2/95
Surveyor's Michigan License No. 25854

45262449