

SURVEY & REMONUMENTATION

APR 25 1995

RC 1584

LAND CORNER RECORDATION CERTIFICATE
Filing Requirement of Act 74, Mich. P.A. 1970

L127800PA651

COMMISSION

For corners in

WAYNE
(County)

Located in: Huron
Township

Corner Code #


- | | | |
|------------------------------------|-------------------------|------------|
| 1. Public Land Survey | T <u>4S</u> R <u>9E</u> | <u>E-2</u> |
| | T _____ R _____ | _____ |
| | T _____ R _____ | _____ |
| | T _____ R _____ | _____ |
| 2. Property Controlling in Section | S _____ T _____ R _____ | _____ |
| | S _____ T _____ R _____ | _____ |
| 3. Miscellaneous Property in Sec. | S _____ T _____ R _____ | _____ |
| | S _____ T _____ R _____ | _____ |

4. Lot No. _____, Recorded Plat _____
5. Private Claims _____

\$ 13.00 MISCELLANEOUS RECORDING
28 DEC 94 9:39 A.M. RECEIPT# 169
RECORDED
FOREST E. YOUNG, REGISTER OF DEEDS
ACT 345, P.A. 1990
APPROVED ON: 12-7-94 *DDJ*
WAYNE COUNTY REMONUMENTATION
PEER GROUP COMMITTEE
Register of Deeds Stamp & File Number

I, Randy Kolehouse, in a field survey on October 20 19 94, do hereby certify that under requirements of P.A. 74 Michigan P.A. of 1970, the corner points mentioned in lines 1 and 2 above were in conformance with regulations and rules therefore as required in the current manual of survey instructions of the United States Department of the Interior, Bureau of Land Management or by a decree of a Court of Law and/or that the corner points mentioned in lines 3, 4 and 5 above were in conformance with the rules of the Michigan Board of Land Surveyors or by a Decree of a Court of Law; established, re-established, monumented, re-monumented, recovered, found as expressed below:

NOTE: Not more than 4 corners, all in the same town and range, may be recorded on this certificate.

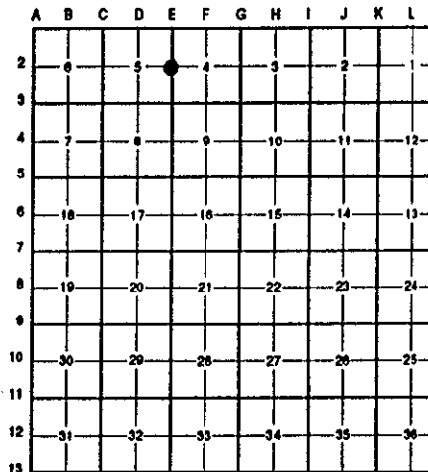

A. Description of original monument and accessories and/or subsequent restoration:

E-2	1817	G.L.O. Notes	N/A	Post
	1930's	WPA Notes	N/A	Iron
	1965	MDOT	Stublts	1/2" Iron Pipe
	1971	D.E. Co. Notes	N/A	3/4" Iron
	1971	Cert. Survey L. 17762 P. 633	Carlson	Iron Stake
	1973	WCRC Notes	N/A	3/4" Iron
	1988	L.C.R.C. & Cert. Survey L. 24065 P. 631-633	Nelson	3/4" Iron Pipe

B. Description of corner evidence found and/or method applied in restoring or reestablishing corner:

E-2 I found 3/4" iron pipe at C/L Intersection of Wahrman Road (gravel) running N-S and Prescott Road (gravel) running East and agrees with the following witnesses.

L.C.R.C. L. 24065 P. 631 & Cert. Survey L. 24065 P. 632 & 633	WCRC
C/L Wayne Co. Water System M/H Az. 74° 74.41' (74.85' m)	Nail & MSHD Tag SW Face D.E. Pole SE'y 68.91' (69.32' m)
Top Nut Hydrant Az. 219° 51.56' (51.52' m)	C/L of Hyd. SW'y 51.62' (51.52' m)
Nail w/Tag "RLS #21273" NE Side P. Pole Az. 329° 36.93' (36.62' m)	

Measures North to E-1 = 2638.71' (G.L.O. = 2640') (WPA = 2638.68') (CS #1940 = 2638.98')
Measures East to F-2 = 2635.72' (WPA = 2633.53')
Measures South to E-3 = 2637.63' (G.L.O. = 2640') (WPA = 2637.78' S-4 & 2638.12' S-5) (CS L. 17762 P. 633 - 2637.60')

C. Description of monument for corner and accessories established to perpetuate locating the position of the corner:

E-2 I replaced the 3/4" pipe with a 4" x 36" concrete monument with aluminum cap stamped "Wayne Co. Remon"

Nail w/Tag "WCR" W Face 10" Poplar N 31° E 70.57'
Nail w/Tag "MSHD" SW Face Util. Pole S 46° E 69.32'
C/L Top Nut Hydrant S 39° W 51.52'
Nail w/Tag "RLS #21273" NE Face Util. Pole 36.62'



The selected location is accepted by the Contractor and is generally accepted by professional surveyors as the best available evidence of the position of the original corner.

Signed by Randy J. Kolehouse
Surveyor's Michigan License No. 25854

Date 12/14/94