

**SURVEY & REMONUMENTATION**

**RC 1118**

DEC 02 1993

**LAND CORNER RECORDATION CERTIFICATE**  
 Filing Requirement of Act 74, Mich. P.A. 1970

**LI 26951 PA 749**

**COMMISSION**  
 For corners in

Wayne (County)	Located In:	Corner Code #
1. Public Land Survey	T <u>4S</u> R <u>9E</u>	<u>E-3</u>
	T _____ R _____	_____
	T _____ R _____	_____
	T _____ R _____	_____
2. Property Controlling in Section	S _____ T _____ R _____	_____
	S _____ T _____ R _____	_____
3. Miscellaneous Property in Sec.	S _____ T _____ R _____	_____
	S _____ T _____ R _____	_____

Compliance with  
 ACT 345, P.A. 1990  
 APPROVED ON: 10-28-93  
 WAYNE COUNTY REMONUMENTATION  
 PEER GROUP COMMITTEE

**RC 1118**

Register of Deeds Stamp & File Number

4. Lot No. \_\_\_\_\_, Recorded Plat \_\_\_\_\_  
 5. Private Claims \_\_\_\_\_

I, Bruce Antcliff, in a field survey on August 18, 19 93, do hereby certify that under requirements of P.A. 74, Michigan P.A. of 1970, the corner points mentioned in lines 1 and 2 above were in conformance with regulations and rules therefore as required in the current manual of survey instructions of the United States Department of the Interior, Bureau of Land Management or by a decree of a Court of Law and/or that the corner points mentioned in lines 3, 4 and 5 above were in conformance with the rules of the Michigan Board of Land Surveyors or by a Decree of a Court of Law; established, re-established, monumented, re-monumented, recovered, found as expressed below:

**NOTE: Not more than 4 corners, all in the same town and range, may be recorded on this certificate.**

A. Description of original monument and accessories and/or subsequent restoration:

- GLO-Post
- WPA (1930's) - Stone
- MDOT-1/2" Pipe
- LCRC (1973)-Iron in Mon. Box (L18394, P 729)


B. Description of corner evidence found and/or method applied in restoring or reestablishing corner:

- 2" Brass "State Highway Marker" in conc. in mon. box
- Measured distance to S 1/4 S.4 checks well with WPA Surveys, MDOT and Rec. Survey L17762, P 633

C. Description of monument for corner and accessories established to perpetuate locating the position of the corner:

- Witnesses
- Top Center Fire Hyd., NW, 68.58'
  - Nail and Tag NW Face P.P., WSW, 116.30'
  - Nail and Tag SW Face P.P., SE, 52.94'
  - P.K. W. Face P.P., NNE, 102.58'

The selected location is accepted by the Contractor and is generally accepted by professional surveyors as the best available evidence of the position of the original corner.

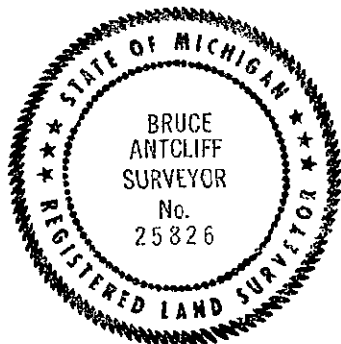

Signed by Bruce Antcliff  
 Surveyor's Michigan License No. 25826

Date 11-10-93

*Handwritten initials*

35 NOV 10 PM 2:27  
 REGISTERED SURVEYOR  
 MICHIGAN