

SURVEY & REMONUMENTATION

RC 1586

L127800PA653

APR 25 1995

\$ 13.00 MISCELLANEOUS RECORDING

LAND CORNER RECORDATION CERTIFICATE

Filing Requirement of Act 74, Mich. P.A. 1970

For corners in **COMMISSION**


Wayne (County)	Located in: Huron Township	Corner Code #
1. Public Land Survey	T <u>4S</u> R <u>9E</u>	<u>E-9</u>
	T _____ R _____	_____
	T _____ R _____	_____
	T _____ R _____	_____
2. Property Controlling in Section	S _____ T _____ R _____	_____
	S _____ T _____ R _____	_____
3. Miscellaneous Property in Sec.	S _____ T _____ R _____	_____
	S _____ T _____ R _____	_____

\$ 13.00 MISCELLANEOUS RECORDING
28 DEC 94 9:39 A.M. RECEIVED
FLORENCE W. YORRIGOLD, REGISTRAR OF DEEDS
Wayne County, Michigan
Compliance with
ACT 345, P.A. 1990
APPROVED ON: 12-7-94 *DDJ*
WAYNE COUNTY REMONUMENTATION
PEER GROUP COMMITTEE

Register of Deeds Stamp & File Number

- 4. Lot No. _____, Recorded Plat _____
- 5. Private Claims _____

I, Randy Kolehouse, in a field survey on October 19 19 94, do hereby certify that under requirements of P.A. 74 Michigan P.A. of 1970, the corner points mentioned in lines 1 and 2 above were in conformance with regulations with regulations and rules therefore as required in the current manual of survey instructions of the United States Department of the Interior, Bureau of Land Management or by a decree of a Court of Law and/or that the corner points mentioned in lines 3, 4 and 5 above were in conformance with the rules of the Michigan Board of Land Surveyors or by a Decree of a Court of Law; established, re-established, monumented, re-monumented, recovered, found as expressed below:

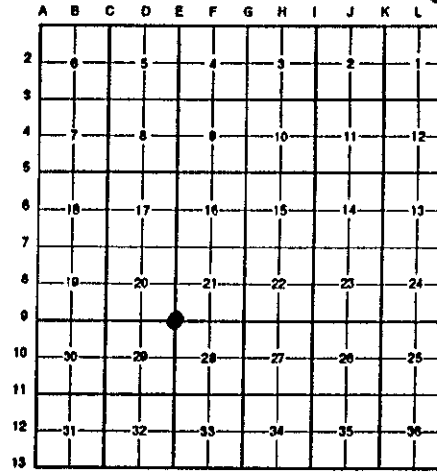

NOTE: Not more than 4 corners, all in the same town and range, may be recorded on this certificate.

A. Description of original monument and accessories and/or subsequent restoration:

Date	Description	Material	Type
E-9 1817	G.L.O. Notes	N/A	Post
1930's	WPA Notes	N/A	Iron
1965	MSHD	N/A	3/4" Iron Pipe
1973	L.C.R.C. & Cert. Survey L. 18479 P. 224 & 223	Crossman	Iron Pipe
1978	WCRC Notes	N/A	3/4" Iron
1985	Cert. Survey L. 2244 P. ___ & ___ #1875	Arthurs	Iron Pipe Stake
1987	L.C.R.C. L. 23239 P. 953	Timmons	3/4" Iron Pipe
1990	Cert. Survey & D.E. Co. Notes	Stephens	3/4" Iron Pipe
1992	Cert. Survey & D.E. Co. Notes	Stephens	3/4" Iron Pipe

B. Description of corner evidence found and/or method applied in restoring or reestablishing corner:


- E-9 I found a 3/4" pipe in C/L of Bell Road (gravel) running N-S which agrees with the following witnesses.
 - MSHD 1965
Tele. Pole N 29° E 74.58' (74.36' m)
 - Cert. Survey CS #1875
Nail & WCRC Shinner S Side Util. Pole WNW'ly 41.42' (41.38' m)
 - L.C.R.C. L. 23239 P. 953
C/L Hyd. S 20° E 90.16' (90.19' m)
 - C/L Fire Hydrant SE'ly 90.19' (90.19' m)
 - WCRC
Nail & Tag S Side D.E. Pole ESE'ly 63.95' (64.04' m)
 - D.E. Co. Cert. Survey 1990 & 1992
C/L Hyd. S 20° E 90.16' (90.19' m)
 - C/L of Hyd. SE'ly 90.15' (90.19' m)
 - Nail & Tag S Face D.E. Pole West 41.44' (41.38' m)

Measures North to E-8 = 2589.63' (G.L.O. = 2640') (WPA = 2589.38' S-20 - 2589.89' S-21) (D.E. Co. = 2589.64')
Measures South to E-10 = 2684.61' (G.L.O. = 2640') (WPA = 2684.32' S-29 - 2684.35' S-28) (CS #1875 = 2684.58') (CS #660 = 2682.41')

C. Description of monument for corner and accessories established to perpetuate locating the position of the corner:

- E-9 I replaced the 3/4" pipe with a 1/2" rod with aluminum cap stamped "Wayne Co. Remon."
 - Nail w/Shiner NW Face Util. Pole N 23° E 74.36'
 - Nail w/Tag "WCRC" S Face Util. Pole S 70° E 64.04'
 - C/L Top Nut Hyd. S 15° E 90.19'
 - Nail w/Tag "WCRC" S Face Util. Pole N 83° W 41.38'

The selected location is accepted by the Contractor and is generally accepted by professional surveyors as the best evidence of the position of the original corner.

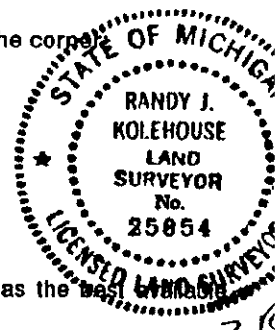

Signed by Randy J. Kolehouse Date 12/14/94
Surveyor's Michigan License No. 25854