

SURVEY & REMONUMENTATION

APR 25 1995

RC 1587

COMMISSION

LAND CORNER RECORDATION CERTIFICATE
Filing Requirement of Act 74, Mich. P.A. 1970

L127800PA654

For corners in

WAYNE (County)	Located in: Huron Township	Corner Code #
1. Public Land Survey	T <u>4S</u> R <u>9E</u>	<u>E-13</u>
	T _____ R _____	_____
	T _____ R _____	_____
	T _____ R _____	_____
2. Property Controlling in Section	S _____ T _____ R _____	_____
	S _____ T _____ R _____	_____
3. Miscellaneous Property in Sec.	S _____ T _____ R _____	_____
	S _____ T _____ R _____	_____
4. Lot No. _____, Recorded Plat _____		
5. Private Claims _____		

Compliance with
ACT 345, P.A. 1990


APPROVED ON: 12-7-94
WAYNE COUNTY REMONUMENTATION
PEER GROUP COMMITTEE

Register of Deeds Stamp & File Number

RC 1587

I, Randy Kolehouse, in a field survey on October 19 19 94, do hereby certify that under requirements of P.A. 74 Michigan P.A. of 1970, the corner points mentioned in lines 1 and 2 above were in conformance with regulations and rules therefore as required in the current manual of survey instructions of the United States Department of the Interior, Bureau of Land Management or by a decree of a Court of Law and/or that the corner points mentioned in lines 3, 4 and 5 above were in conformance with the rules of the Michigan Board of Land Surveyors or by a Decree of a Court of Law; established, re-established, monumented, re-monumented, recovered, found as expressed below:

NOTE: Not more than 4 corners, all in the same town and range, may be recorded on this certificate.

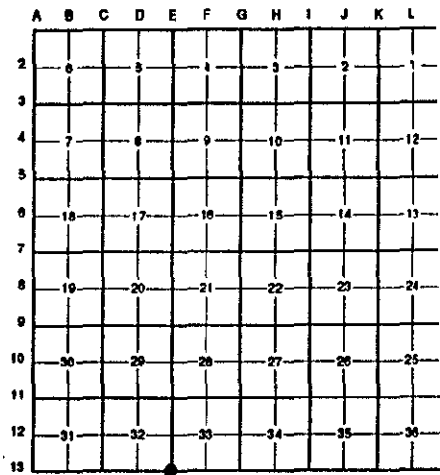

A. Description of original monument and accessories and/or subsequent restoration:

Date	Notes	Monument
E-13 1817	G.L.O. Notes	N/A
1930's	WPA Notes	N/A
1965	MDSH Notes	N/A
1974	WCRC Notes	N/A
1977	L.C.R.C. L. 19705 P. 97	Hobgood

B. Description of corner evidence found and/or method applied in restoring or reestablishing corner:

E-13 I found 1/2" rebar in monument box at C/L of Will Carleton Road (concrete) running E-W 31.44' West of monument in a monument box at C/L Grafton Road running South which agrees with the following witnesses.

MDSH Witnesses 1965 Monument East 31.43' (31.44' m)	WCRC Mon. East 31.45' (31.44' m)
--	-------------------------------------

MDSH Witness 1977 and L.C.R.C. L. 19705 P. 97
P.K. w/Tag Edison Pole S 10° W 66.26' (66.29' m)
Nail & Tag P. Pole S 60° E 88.95' (89.03' m)
Monument East 31.43' (31.44' m)


Measures East to F-13 = 2643.46' (G.L.O. = 2640') (WPA = 2642.92') (MSHD = 2643.19')
Measures West to C-13 = 5269.04' (G.L.O. = 5280') (WPA = 5269.23')

\$ 13.00 MISCELLANEOUS RECORDING
28 DEC 94 9:39 A.M. RECEIPT# 168
RECORDED
FOREST E. YOUNGBLOOD, REGISTER OF DEEDS
WAYNE COUNTY, MI

C. Description of monument for corner and accessories established to perpetuate locating the position of the corner:

E-13 I set an aluminum cap "Wayne Co. Remon." on existing iron, in an existing monument box.

P.K. W Face Util. Pole 6' M/L Off Ground N 54° E 114.80'
Mon. in Box C/L C/L Will Carleton & Grafton S 86° E 31.44'
Nail w/Shinner NE Face Util. Pole S 57° E 89.03'
P.K. w/Shinner NW Face Util. Pole 4' M/L Off Ground S 15° W 66.29'
Drill Hole in West End Conc. Culvert N 07° E 59.95'

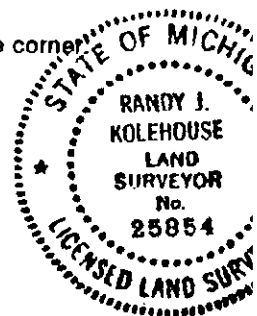

The selected location is accepted by the Contractor and is generally accepted by professional surveyors as the best available evidence of the position of the original corner.

Signed by Randy J. Kolehouse Date 12/14/94
Surveyor's Michigan License No. 25854