

APR 25 1995

\$ 13.00 MISCELLANEOUS RECORDING

COMMISSION

LAND CORNER RECORDATION CERTIFICATE Filing Requirement of Act 74, Mich. P.A. 1970

28 DEC 94 9:39 A.M. RECEIVED

For corners in

<u>WAYNE</u> (County)	Located In: Huron Township	Corner Code # <u>G-2</u>
1. Public Land Survey	T <u>4S</u> R <u>9E</u>	<u>G-2</u>
	T _____ R _____	_____
	T _____ R _____	_____
	T _____ R _____	_____
2. Property Controlling in Section	S _____ T _____ R _____	_____
	S _____ T _____ R _____	_____
3. Miscellaneous Property in Sec.	S _____ T _____ R _____	_____
	S _____ T _____ R _____	_____

FOREST E. YONGALOOD, REGISTER OF DEEDS
WAYNE COUNTY, MI


Compliance with
ACT 345, P.A. 1990

APPROVED ON: 12-7-94
WAYNE COUNTY REMONUMENTATION
PEER GROUP COMMITTEE

Register of Deeds Stamp & File Number

RC 1588

- 4. Lot No. _____, Recorded Plat _____
- 5. Private Claims _____

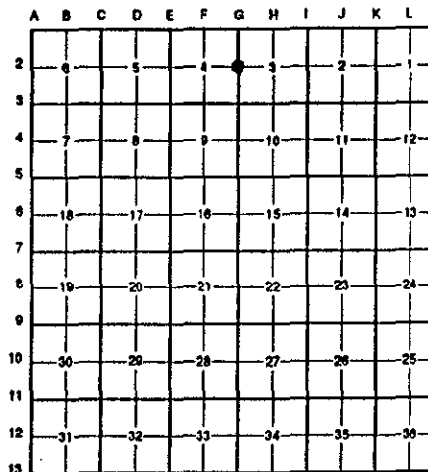

I, Randy Kolehouse, in a field survey on October 19 19 94, do hereby certify that under requirements of P.A. 74 Michigan P.A. of 1970, the corner points mentioned in lines 1 and 2 above were in conformance with regulations and rules therefore as required in the current manual of survey instructions of the United States Department of the Interior, Bureau of Land Management or by a decree of a Court of Law and/or that the corner points mentioned in lines 3, 4 and 5 above were in conformance with the rules of the Michigan Board of Land Surveyors or by a Decree of a Court of Law; established, re-established, monumented, re-monumented, recovered, found as expressed below:

NOTE: Not more than 4 corners, all in the same town and range, may be recorded on this certificate.

A. Description of original monument and accessories and/or subsequent restoration:

G-2	1817	G.L.O. Notes	N/A	Post
	1930's	WPA Notes	N/A	Iron
	1973	L.C.R.C. L. 18340 P. 692	Crossman	Iron Pipe
	1973	WCRC Notes	N/A	Iron in Mon. Box
	1977	L.C.R.C. L. 19776 P. 101	Hobgood	1/4" Iron in Mon. Box
	1977	Cert. Survey L. 19748 P. 548	N/A	N/A
	1987	WCRC Notes	N/A	1/2" Iron in Mon. Box

B. Description of corner evidence found and/or method applied in restoring or reestablishing corner:

G-2 I found 1/2" rebar in monument box at C/L Vining Road (asphalt) running N-S and Prescott Road (gravel) running E-W which agrees with the following witnesses.

L.C.R.C. L. 19776 P. 101
C/L Top Nut Hyd. N 42° E 60.31' (60.31')

WCRC 1973
C/L of Hyd. NE 60.30' (60.31' m)

Cert. Survey L. 19748 P. 548
C/L Top Nut Hyd. N 42° E 60.31' (60.31')


WCRC 1987
C/L of Hyd. NE 60.30' (60.31' m)
Nail w/Tag "WCRC" Corner Post SW 42.89' (42.65' m)
Nail w/Tag "WCRC" D.E. Pole SE 37.47' (37.51' m)

Measures East to H-1 = 2643.92' (WPA = 2643.85')
Measures South to G-3 = 2631.32' (G.L.O. = 2574.0') (WPA = 2631.46' S-3 - 2631.15' S-4)
Measures West to F-2 = 2634.58' (WPA = 2634.75')

C. Description of monument for corner and accessories established to perpetuate locating the position of the corner:

G-2 I set an aluminum cap stamped "Wayne Co. Remon." on existing iron in an existing monument box.

C/L Top Nut Hyd. N 43° E 60.31'
Nail w/Tag "WCR" NE Face Util. Pole S 46° E 40.45'
P.K. E Face Util. Pole S 58° W 44.32'
P.K. E Face Util. Pole N 53° W 49.20'

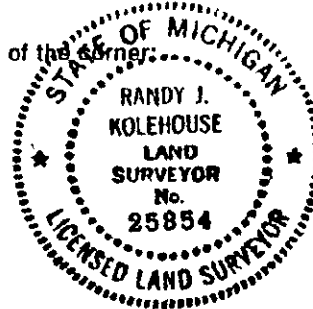

The selected location is accepted by the Contractor and is generally accepted by professional surveyors as the best available evidence of the position of the original corner.

Signed by Randy J. Kolehouse Date 12/14/94
Surveyor's Michigan License No. 25854