

FILE DO NOT MAIL

LAND CORNER RECORDATION CERTIFICATE
 Filing Requirement of Act 74, Mich. P.A. 1970

SURVEY & REMONUMENTATION

For corners in

<u>WAYNE</u> (County)	Located in: Huron Township	Corner Code #
1. Public Land Survey	T <u>4S</u> R <u>9E</u>	<u>G-5</u>
	T _____ R _____	_____
	T _____ R _____	_____
	T _____ R _____	_____
2. Property Controlling in Section	S _____ T _____ R _____	_____
	S _____ T _____ R _____	_____
3. Miscellaneous Property in Sec.	S _____ T _____ R _____	_____
	S _____ T _____ R _____	_____

MAR 17 1998

SECTION

Compliance with
 ACT 345, P.A. 1990

APPROVED ON: 12-1-97 *DPJ*
WAYNE COUNTY REMONUMENTATION
PEER GROUP COMMITTEE
 Register of Deeds Stamp & File Number


4. Lot No. _____, Recorded Plat _____
 5. Private Claims _____

I, Randy Kolehouse, in a field survey on November 6 19 97, do hereby certify that under requirements of P.A. 74 Michigan P.A. of 1970, the corner points mentioned in lines 1 and 2 above were in conformance with regulations and rules therefore as required in the current manual of survey instructions of the United States Department of the interior, Bureau of Land Management or by a decree of a Court of Law and/or that the corner points mentioned in lines 3, 4 and 5 above were in conformance with the rules of the Michigan Board of Land Surveyors or by a Decree of a Court of Law; established, re-established, monumented, re-monumented, recovered, found as expressed below:

NOTE: Not more than 4 corners, all in the same town and range, may be recorded on this certificate.

A. Description of original monument and accessories and/or subsequent restoration:

G-5	1. 1817	G.L.O.	Fletcher	Notes	Post
	2. 1930's	WPA Notes	N/A	Section Map and Ties	Iron
	3. 1971	L.C.R.C.	Crossman #9428	L. 17718 P. 598	Monument in Box
	4. 1972	Cert. Survey	R. Campbell Jr. #13028	L. 18143 P. 32-33	Monument in Box
	5. 1972	L.C.R.C.	R. Campbell Jr. #13028	L. 18143 P. 30	Monument in Box
	6. 1973	W.C.R.C.	Coon	Witness Record	Monument in Box
	7. 1975	Cert. Survey	Arthurs #11358	L. 19107 P. 106	N/A
	8. 1979	Cert. Survey	Arthurs #11358	L. 20676 P. 667-668	Monument in Box
	9. 1983	Cert. Survey	Ayers #4615	L. 21798 P. 85-90	Monument in Box

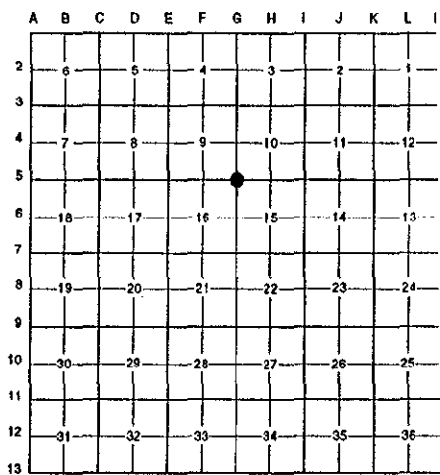

B. Description of corner evidence found and/or method applied in restoring or reestablishing corner:

G-5 Found a concrete monument in a monument box at the C/L intersection of Huron River Drive (asph.) running West and South, King Road (gravel) running East, and Vinning Road (asph.) running North per the following witnesses:
 Nail NW face util. Pole, M= N58E 36.12', R= 36.02' (4 & 5), 36.00' (9): PK N face util. Pole, M= S37E 40.31', R= 40.33' (4 & 5): Nail w/WCRC tag SE face util pole, M=S71W 80.97', R= 80.92' (6 & 7): Center top nut hydrant, M= N60W 59.95', R= 59.96' (4 & 5), 59.91' (6), 60.05' (8), 59.95' (9).

\$4.00 REMONUMENTATION
 RECORDED
 FOREST E. YOUNGLOOD, REGISTER OF DEEDS
 WAYNE COUNTY, MI
 Receipt #43169

Measure West to F-5 = 2634.97' (W.P.A = 2634.71') (G.L.O. = 2643.0) (Arthurs = 2634.86')
 Measure North to G-4 = 2642.30' (WPA = 2642.54') (G.L.O. = 2640.0')
 Measure East to H-5 = 2645.05' (WPA = 2645.32') (G.L.O. = 2640.0')

C. Description of monument for corner and accessories established to perpetuate locating the position of the corner:

G-5 Set a 2" diameter aluminum cap stamped "Wayne County Remon. #25854" on an existing 4" x 36" concrete monument in an existing monument box.

- *+ SW Rim San. M/H N 27° E 70.52'
- Nail in NW Face Util. Pole N 58° E 36.12'
- Nail w/W.C.R. Tag NE Face Util. Pole S 37° E 40.44'
- Nail w/W.C.R. Tag in SE Face Util. Pole S 71° W 80.95'
- C/L Top Nut Hydrant N 60° W 59.95'
- P.K. Nail W/Tag "AMBIT #30096" S Face Util Pole N 73° W 135.01'
- U.S.G.S. BM #TT26L S 26° W 96.25'

The selected location is accepted by the Contractor and is generally accepted by professional surveyors as the best available evidence of the position of the original corner.

Signed by Randy J. Kolehouse Date 12/16/97
 Surveyor's Michigan License No. 25854

