

**SURVEY &  
REMONUMENTATION**

**RC 1121**

DEC 02 1993

**LAND CORNER RECORDATION CERTIFICATE  
Filing Requirement of Act 74, Mich. P.A. 1970**

**LI 26951 PA 752**

For corners in \_\_\_\_\_

| Wayne<br>(County)                     | Located In:             | Corner Code # |
|---------------------------------------|-------------------------|---------------|
| 1. Public Land Survey                 | T <u>4S</u> R <u>9E</u> | <u>G-7</u>    |
|                                       | T _____ R _____         | _____         |
|                                       | T _____ R _____         | _____         |
|                                       | T _____ R _____         | _____         |
| 2. Property Controlling<br>in Section | S _____ T _____ R _____ | _____         |
|                                       | S _____ T _____ R _____ | _____         |
| 3. Miscellaneous<br>Property in Sec.  | S _____ T _____ R _____ | _____         |
|                                       | S _____ T _____ R _____ | _____         |

Compliance with  
ACT 345, P.A. 1990

APPROVED ON: 10-28-93 TCD  
WAYNE COUNTY REMONUMENTATION  
PEER GROUP COMMITTEE

Register of Deeds Stamp & File Number

RC 1121

4. Lot No. \_\_\_\_\_, Recorded Plat \_\_\_\_\_  
5. Private Claims \_\_\_\_\_

|    | A  | B | C  | D | E  | F | G  | H | I  | J | K  | L | M |
|----|----|---|----|---|----|---|----|---|----|---|----|---|---|
| 2  | 6  |   | 5  |   | 4  |   | 3  |   | 2  |   | 1  |   |   |
| 3  |    |   |    |   |    |   |    |   |    |   |    |   |   |
| 4  | 7  |   | 8  |   | 9  |   | 10 |   | 11 |   | 12 |   |   |
| 5  |    |   |    |   |    |   |    |   |    |   |    |   |   |
| 6  | 18 |   | 17 |   | 16 |   | 15 |   | 14 |   | 13 |   |   |
| 7  |    |   |    |   |    |   |    |   |    |   |    |   |   |
| 8  | 19 |   | 20 |   | 21 |   | 22 |   | 23 |   | 24 |   |   |
| 9  |    |   |    |   |    |   |    |   |    |   |    |   |   |
| 10 | 30 |   | 29 |   | 28 |   | 27 |   | 26 |   | 25 |   |   |
| 11 |    |   |    |   |    |   |    |   |    |   |    |   |   |
| 12 | 31 |   | 32 |   | 33 |   | 34 |   | 35 |   | 36 |   |   |
| 13 |    |   |    |   |    |   |    |   |    |   |    |   |   |

I, Bruce Antcliff, in a field survey on August 19, 19 93, do hereby certify that under requirements of P.A. 74, Michigan P.A. of 1970, the corner points mentioned in lines 1 and 2 above were in conformance with regulations and rules therefore as required in the current manual of survey instructions of the United States Department of the Interior, Bureau of Land Management or by a decree of a Court of Law and/or that the corner points mentioned in lines 3, 4 and 5 above were in conformance with the rules of the Michigan Board of Land Surveyors or by a Decree of a Court of Law: established, re-established, monumented, re-monumented, recovered, found as expressed below.

**NOTE: Not more than 4 corners, all in the same town and range, may be recorded on this certificate.**

A. Description of original monument and accessories and/or subsequent restoration:

- GLO-Post
- WPA (1930's) - Iron
- LCRC (1974)-Mon. in Handhole (L18748, P 447)
- LCRC (1975)-Mon. in Handhole (L19232, P 320)
- LCRC (1986)-3/4" Iron in Box (L23941, P 410)
- LCRC (1990)-1/2" Iron in Box (L24606, P 053)

B. Description of corner evidence found and/or method applied in restoring or reestablishing corner:

Con. Mon. in Mon. Box; Measured to S 1/4 S.15 and SE S.15-  
Both check well w/WPA Surveys.

C. Description of monument for corner and accessories established to perpetuate locating the position of the corner:

Set Wayne County Remonumentation Marker and Cap #25826 on exist. monument


Witnesses

- P.K. SE Face Guy Pole, SW, 63.61'
- P.K. SW Face P.P, SE, 76.55'
- P.K. NW Face Guy Pole, NE, 70.12'
- Top Center Fire Hyd., NNE, 57.73'

The selected location is accepted by the Contractor and is generally accepted by professional surveyors as the best available evidence of the position of the original corner.

Signed by Bruce Antcliff  
Surveyor's Michigan License No. 25826

Date 11-10-93

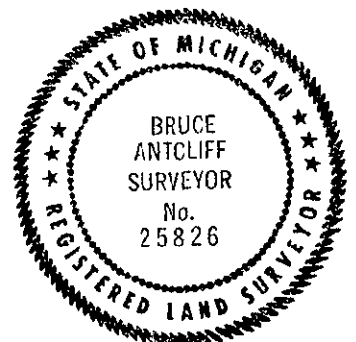

93 NOV 10 PM 2:27  
WAYNE COUNTY