

FILE DO NOT MAIL

LAND CORNER RECORDATION CERTIFICATE
Filing Requirement of Act 74, Mich. P.A. 1970

For corner in 10001092
Wayne (County)

Located In: Huron Twp. Corner Code #

Table with 3 columns: Survey Type, T/R/S/E, and Corner Code #. Includes rows for Public Land Survey, Property Controlling in Section, and Miscellaneous Property in Sec.

Liber-30864 Page-2
99595528 12/30/1999
F.E. Youngblood, Wayne Co. Register of Deeds


Compliance with ACT 345, P.A. 1990

APPROVED ON: 12-8-99
WAYNE COUNTY REMONUMENTATION
PEER GROUP COMMITTEE

Register of Deeds Stamp & File Number

4. Lot No. Recorded Plat
5. Private Claims

I, Michael S. Hoben, in a field survey on Sept. 22, 1999 do hereby state that under requirements of P.A. 74, Michigan P.A. of 1970, the corner points mentioned in lines 1 and 2 above were in conformance with regulations and rules therefore as required in the current manual of survey instructions of the United States Department of the Interior, Bureau of Land Management or by a decree of a Court of Law and /or that the corner points mentioned in lines 3, 4 and 5 above were in conformance with the rules of the Michigan Board of Land Surveyors or by a Decree of a Court of Law; established, re-established, monumented, recovered, found as expressed below:

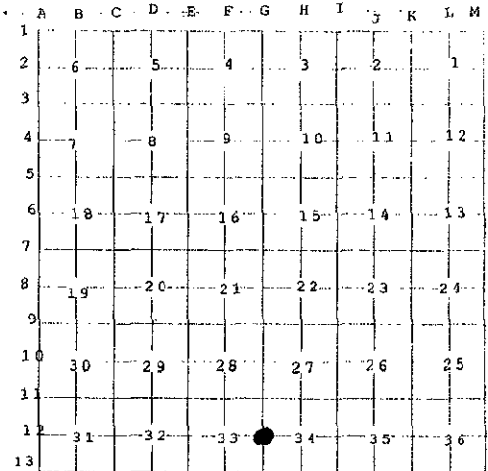

NOTE: Not more than 2 corners, all in the same town and range, may be recorded on this certificate.

A. Description of original monument and accessories and/or subsequent restoration:

Table with 5 columns: Survey Type, Witness/Dimensions, Monument Type, Material, and Post Type. Includes entries for 1817 GLO Notes, 1930's witnesses, 1930's dimensions, and 1974.

RF
FEB 28 2000
SECTION

B. Description of corner evidence found and/or method applied in restoring or reestablishing corner:

G-12 I found a 3/4" rebar, 2' +/- west of the centerline of Romine Rd. (gravel). This point falls on a tree row to the east and west.


Distance to G-11 = 2626.85' (GLO = 2640')(WPA = 2626.52' Section 33, 2626.50' Section 34)
Distance to G-13 = 2628.29' (GLO = 2640')(WPA = 2628.51' Section 33, 2628.49' Section 34)
Measured angle is 179°55'44"; Record angle is 179°55'50" in Section 33 and 179°56'10" in Section 34.

(over)

C. Description of monument for corner and accessories established to perpetuate locating the position of the corner:

G-12 I replaced the found 3/4" rebar with a 1/2" x 18" rebar with a 2" aluminum cap stamped "Wayne County Monument MI Act 345 #35994" in gravel road

Table with 3 columns: Direction, Distance, and Monument Description. Includes entries for N 20° E, S 11° E, S 80° W, N 20° W, and East.

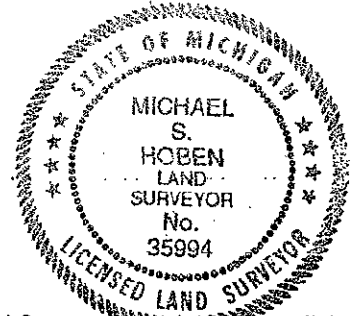

The selected location is accepted by me and is generally accepted by Professional Surveyors as the best available evidence of the position of the original corner.

Signed by Michael S. Hoben

Date Dec. 27, 1999

Surveyor's Michigan License No. 35994

FORM APPROVED BY MICHIGAN STATE BOARD OF LAND SURVEYORS, JAN. 28, 1971

REVISED MAY 14, 1975
REVISED JAN., 1983
REVISED OCT., 1999

R LCR 12 4R 2 Pgs A. DPZ

WPA witnesses 1930's

NE 115.77' Tel pole (gone)

SE 94.18' Tel pole

SW 138.25' 22" Elm (gone)

SW 47.85' FP. (gone)

W 27.64' FP. (gone)

Liber-30864

Page-3

WCRC Witnesses 1974

W 27.64' FP.

E 32.50' 10" Elm. (gone)

SE 93.70' MBT pole.

SW 127.40' NE corner of house #27900. (gone)

SW 32.38' 16" Oak (gone)

RECEIVED &
RECORDED

FEB 28 2000

SECTION