

FILE DO NOT MAIL

SURVEY & REMONUMENTATION
LAND CORNER RECORDATION CERTIFICATE
Filing Requirement of Act 74, Mich. P.A. 1970

For corners in

WAYNE (County)	Located in: Huron Township	Corner Code #
1. Public Land Survey	T <u>4S</u> R <u>9E</u>	<u>I-5</u>
	T _____ R _____	_____
	T _____ R _____	_____
	T _____ R _____	_____
2. Property Controlling in Section	S _____ T _____ R _____	_____
	S _____ T _____ R _____	_____
3. Miscellaneous Property in Sec.	S _____ T _____ R _____	_____
	S _____ T _____ R _____	_____

MAR 17 1998


SECTION

Compliance with
ACT 345, P.A. 1990

APPROVED ON: 12-1-97 *DOJ*
WAYNE COUNTY REMONUMENTATION
PEER GROUP COMMITTEE
Register of Deeds Stamp & File Number

4. Lot No. _____, Recorded Plat _____
5. Private Claims _____

I, Randy Kolehouse, in a field survey on November 5 19 97, do hereby certify that under requirements of P.A. 74 Michigan P.A. of 1970, the corner points mentioned in lines 1 and 2 above were in conformance with regulations and rules therefore as required in the current manual of survey instructions of the United States Department of the Interior, Bureau of Land Management or by a decree of a Court of Law and/or that the corner points mentioned in lines 3, 4 and 5 above were in conformance with the rules of the Michigan Board of Land Surveyors or by a Decree of a Court of Law; established, re-established, monumented, re-monumented, recovered, found as expressed below:

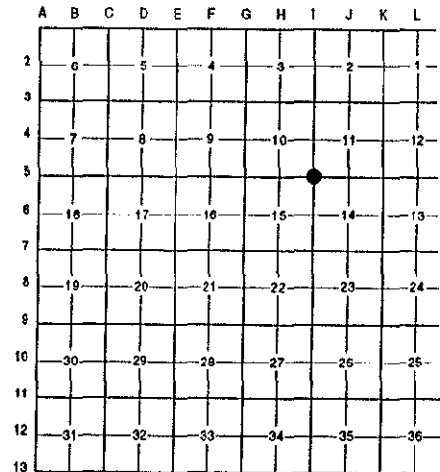

NOTE: Not more than 4 corners, all in the same town and range, may be recorded on this certificate.

A. Description of original monument and accessories and/or subsequent restoration:

I-5	Description	Fletcher	Notes	Post	Cost
1.	1817 G.L.O.	Fletcher	Notes	Iron	\$4.00 REMONUMENTATION
2.	1930's WPA Notes	N/A	Section Map and Ties	Iron Pipe	
3.	1972 L.C.R.C.	Campbell #13028	L. 18045 P. 933	Iron Pipe	
4.	1972 Cert. Survey	Campbell #13028	L. 18047 P. 841-842	Iron Pipe	
5.	1973 Cert. Survey	Stanley #12031	L. 18387 P. 789-790	N/A	
6.	1973 W.C.R.C.	Coon	Witness Record	3/4" Iron	
7.	1974 Cert. Survey	Stanley #12031	L. 18794 P. 367	N/A	
8.	1976 Cert. Survey	Crossman #9428	L. 19534 P. 497	Iron Pipe	
9.	1980 Cert. Survey	Crossman #9428	L. 21023 P. 553-554	N/A	
10.	1981 Unrec. Survey	Pettibone	DECO Survey	3/4" Iron Pipe	
11.	1981 DECO Notes	Pettibone	DECO Survey	3/4" Iron Pipe	
12.	1990 DECO Notes	Stephens	DECO Survey	3/4" Iron Pipe	
13.	1990 Cert. Survey	Blanchard #27446	L. 24573 P. 646-648	N/A	

B. Description of corner evidence found and/or method applied in restoring or reestablishing corner:

I-5 Found a 1/2" pipe at the C/L intersection of King Road (gravel) running East and West and Merriman Road (gravel) running North and South per the following witnesses. Nail SW face util pole, M= N22W 64.96', R= 64.86' (10), 64.99' (6), 64.78' (3): Nail w/WCRC tag SE face util pole, M= N52E 49.62', R= 49.08' (9): Nail N face util pole, M= S63E 71.70', R= 71.89' (3), 72.06' (10): Nail/shiner SW face util pole, M= S63E 71.62', R= 71.89' (9): Center top nut hydrant, M=S51E 63.08', R= 63.11' (6 & 8): PK w/WCRC tag SE face util pole, M=S56W 41.64', R= 41.69' (6), 41.54' (8): Nail w/WCRC tag NW face util pole, M= S56W 41.73', R= 41.50' (3 & 9), 41.59' (10).

Measure West to H-5 = 2642.53' (WPA = 2642.63') (G.L.O. = 2640.0') (Blanchard = 2642.61')
Measure North to I-4 = 2622.75' (WPA = 2622.52') (G.L.O. = 2640.0') (DECO = 2622.79')
Measure East to J-5 = 2611.30' (WPA = 2610.36') (G.L.O. = 2648.25')
Measure South to I-6 = 2641.77' (WPA = 2640.80') (G.L.O. = 2640.0') (DECO = 2641.82')

RECORDED
FOREST E. YOUNGBLOOD, REGISTER
WAYNE COUNTY, MI
Receipt #43169

C. Description of monument for corner and accessories established to perpetuate locating the position of the corner:

I-5 Replaced an existing 1/2" pipe with a 4" x 36" concrete monument with a 2" diameter aluminum cap stamped "Wayne County Remon. #25854."

\$7.00 DEED

Nail w/W.C.R. Tag in NE Face Util. Pole N 22° W 64.96'
P.K. Nail in NW Face Util. Pole N 52° E 49.39'
Nail w/W.C.R.C. Tag in SE Face Util. Pole N 52° E 49.62'
Nail w/W.C.R. Tag in SW Face Util. Pole S 63° E 71.51'

C/L Top Nut Hydrant S 51° E 63.08'
Nail w/W.C.R.C. Tag in NW Face Util. Pole S 56° W 41.73'

The selected location is accepted by the Contractor and is generally accepted by professional surveyors as the best available evidence of the position of the original corner.

Signed by Randy J. Kolehouse Date 12/16/97
Surveyor's Michigan License No. 25854

