

**SURVEY &
REMONUMENTATION**

RC 1590

APR 25 1995

**LAND CORNER RECORDATION CERTIFICATE
Filing Requirement of Act 74, Mich. P.A. 1970**

COMMISSION

For corners in

<u>WAYNE</u> (County)	Located in: Huron Township	Corner Code #
1. Public Land Survey	T <u>4S</u> R <u>9E</u>	<u>I-7</u>
	T _____ R _____	_____
	T _____ R _____	_____
	T _____ R _____	_____
2. Property Controlling in Section	S _____ T _____ R _____	_____
	S _____ T _____ R _____	_____
3. Miscellaneous Property in Sec.	S _____ T _____ R _____	_____
	S _____ T _____ R _____	_____

L127800PA657

Compliance with
ACT 345, P.A. 1990


APPROVED ON: 12-7-94 *[Signature]*
WAYNE COUNTY REMONUMENTATION
PEER GROUP COMMITTEE

Register of Deeds Stamp & File Number

4. Lot No. _____, Recorded Plat _____
5. Private Claims _____

I, Randy Kolehouse, in a field survey on November 4 19 94, do hereby certify that under requirements of P.A. 74 Michigan P.A. of 1970, the corner points mentioned in lines 1 and 2 above were in conformance with regulations and rules therefore as required in the current manual of survey instructions of the United States Department of the Interior, Bureau of Land Management or by a decree of a Court of Law and/or that the corner points mentioned in lines 3, 4 and 5 above were in conformance with the rules of the Michigan Board of Land Surveyors or by a Decree of a Court of Law; established, re-established, monumented, re-monumented, recovered, found as expressed below:

NOTE: Not more than 4 corners, all in the same town and range, may be recorded on this certificate.

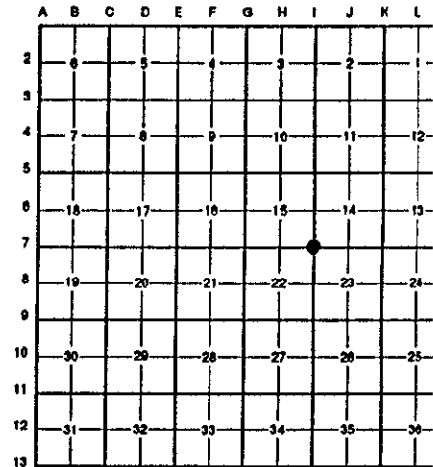

A. Description of original monument and accessories and/or subsequent restoration:

I-7	1817	G.L.O. Notes	N/A	Post
	1930's	WPA Notes	N/A	Iron
	1973	L.C.R.C. L. 18578 P. 880	Crossman	Iron Pipe
	1975	L.C.R.C. L. 19245 P. 600	Swanson	3/4" Iron Pipe

\$ 13.00 MISCELLANEOUS RECORDING
28 DEC 94 9:39 A.M. RECEIPT# 16
RECORDED
FOREST E. YOUNGBLOOM, REGISTER OF DEEDS
WAYNE COUNTY, MI

B. Description of corner evidence found and/or method applied in restoring or reestablishing corner:

I-7 I found 3/4" iron pipe at the C/L intersection of West Road running E-W and Merriman (gravel) running N-S which agrees with the following witnesses.

L.C.R.C. L. 18578 P. 880
Believe Witnesses for I-6 & I-7 are reversed. The following agree with the cor. at I-7 but listed under I-6.
SSW 64.68' Spike w/Brass Tag
Top Bolt Hyd. N 36° E 53.00' (52.97' m)
Nail & Cap N Side D.E. Pole S 63° E 54.63' (54.64' m)
Nail & Cap NE Side 24" Maple S 20W 63.04' (62.72' m)

L.C.R.C. L. 19245 P. 600
NE 52.98' C/L Hyd. Valve Nut (52.97' m)
ESE 55.26' Spike w/Brass Tag SW Face D.E. Pole (55.25' m)
SSW 64.68' Spike w/Brass Tag SE Side 30" Oak (64.60' ± m)
SW 76.59' Spike w/Brass Tag NW Side MBT Pole (76.56' m)


Measures East to K-7 = 5264.28' (G.L.O. = 5280') (WPA = 5264.12')
Measures South to I-8 = 2617.83' (G.L.O. = 2640') (WPA = 2617.03' S-22 - 2617.15' S-23)
Measures West to H-7 = 2655.08' (G.L.O. = 2649.90') (WPA = 2655.22' S-15 - 2654.77' S-22)

C. Description of monument for corner and accessories established to perpetuate locating the position of the corner:

I-7 Replaced 3/4" pipe with 4" x 36" concrete monument with aluminum cap stamped "Wayne Co. Remon."

C/L Top Nut Hyd. N 35° E 52.97'
P.K. S Face Util. Pole S 76° E 67.94'
Nail w/Tag "WCRC" SW Face Util. Pole S 57° E 55.25'
Nail w/Tag "WCR" SE Face 36" Oak S 30° W 64.60'
Nail w/Tag "WCRC" N Face Util. Pole S 76° W 76.56'

The selected location is accepted by the Contractor and is generally accepted by professional surveyors as the best available evidence of the position of the original corner.

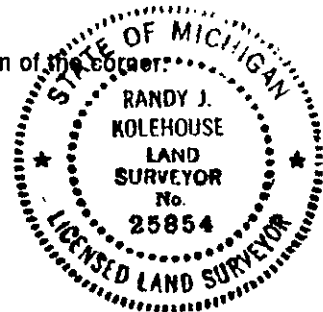

Signed by Randy J. Kolehouse Date 12/14/94
Surveyor's Michigan License No. 25854