

DEC 21 1998

SURVEY & REMONUMENTATION

FILE DO NOT MAIL

MAR 02 1999

LAND CORNER RECORDATION CERTIFICATE
Filing Requirement of Act 74, Mich. P.A. 1970

SECTION

For corners in

WAYNE (County)	Located in: Huron Township	Corner Code #
1. Public Land Survey	T <u>4S</u> R <u>9E</u>	<u>I-12</u>
	T _____ R _____	_____
	T _____ R _____	_____
	T _____ R _____	_____
2. Property Controlling in Section	S _____ T _____ R _____	_____
	S _____ T _____ R _____	_____
3. Miscellaneous Property in Sec.	S _____ T _____ R _____	_____
	S _____ T _____ R _____	_____

Compliance with
ACT 345, P.A. 1990

APPROVED ON: 12-15-98
WAYNE COUNTY REMONUMENTATION
PEER GROUP COMMITTEE
DBL
Register of Deeds Stamp & File Number


4. Lot No. _____, Recorded Plat _____
5. Private Claims _____

I, Bruce Antcliff, in a field survey on October 23 19 98, do hereby certify that under requirements of P.A. 74 Michigan P.A. of 1970, the corner points mentioned in lines 1 and 2 above were in conformance with regulations and rules therefore as required in the current manual of survey instructions of the United States Department of the interior, Bureau of Land Management or by a decree of a Court of Law and/or that the corner points mentioned in lines 3, 4 and 5 above were in conformance with the rules of the Michigan Board of Land Surveyors or by a Decree of a Court of Law; established, re-established, monumented, re-monumented, recovered, found as expressed below:

NOTE: Not more than 4 corners, all in the same town and range, may be recorded on this certificate.

A. Description of original monument and accessories and/or subsequent restoration:

I-12	Description	Fletcher	Notes	Post
1. 1817	G.L.O.	Fletcher		Post
2. 1930's	WPA Notes	N/A	Section Map and Ties	Iron
3. 1964	H.C.M.A. Land Acquisition Map	N/A	N/A	N/A

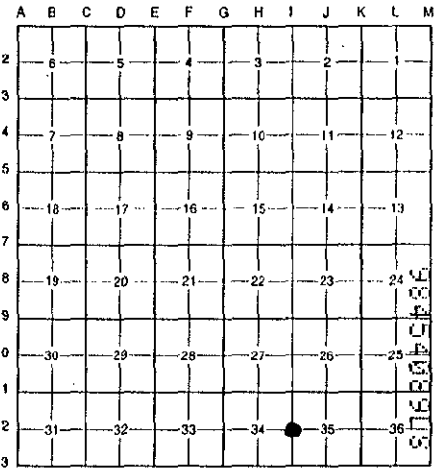

\$7.00 DEED

B. Description of corner evidence found and/or method applied in restoring or reestablishing corner:

I-12 Nothing found at this location. I proportioned the corner location from the Huron-Clinton Metropolitan Authority survey map of the metro-park. The corner fell on an old E/W fence and also checked well with WPA dimensions.

\$4.00 REMONUMENTATION
RECORDED
FOREST E. YOUNGBLOOD, REGISTER OF DEEDS
WAYNE COUNTY, MI
Receipt #101302


Measure East to J-12 = 2650.14' (WPA = 2650.03')(H.C.M.A. = 2651.1')
Measure West to H-12 = 2637.36 (H.C.M.A. = 2638.32')
Measure North to I-11 = 2641.80 (WPA = 2642.47', 2641.65' & 2641.94')(G.L.O. = 2640.00')(H.C.M.A. = 2642.70')
Measure South to I-13 = 2636.84' (WPA = 2636.34' & 2637.48')(G.L.O. = 2640.00')

C. Description of monument for corner and accessories established to perpetuate locating the position of the corner:

I-12 Set 4" x 36" concrete monument with a 1/2" rebar and a 2" diameter aluminum cap stamped "Wayne Co. Remon. #25826". (Not in roadway.)

Fnd. P.K. nail in N. root of 24" hickory, S45°E, 14.20'
Set nail w/WCR tag E. side 24" oak, S06°E, 34.65'
Set nail w/WCR tag N. side 4"x6" post for "Sun" pipeline, N85°W, 31.05'
Set "+" s'ly rim sanitary manhole, N53°E, 79.27'

The selected location is accepted by the Contractor and is generally accepted by professional surveyors as the best available evidence of the position of the original corner.

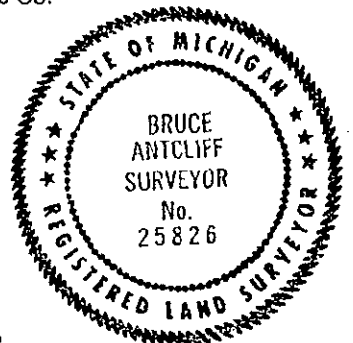

Signed by Bruce Antcliff Date 12-17-98

Surveyor's Michigan License No. 25826

R LCR 7 4R 1PG U DBL

Libar-30031

Page-753.0

12/21/1998 09:26AM