

APR 05 1996 LAND CORNER RECORDATION CERTIFICATE
Filing Requirement of Act 74, Mich. P.A. 1970

For corners in **COMMISSION**

<u>WAYNE</u> (County)	Located in: Huron Township	Corner Code #
1. Public Land Survey	T <u>4S</u> R <u>9E</u>	<u>I-13</u>
	T _____ R _____	_____
	T _____ R _____	_____
	T _____ R _____	_____
2. Property Controlling in Section	S _____ T _____ R _____	_____
	S _____ T _____ R _____	_____
3. Miscellaneous Property in Sec.	S _____ T _____ R _____	_____
	S _____ T _____ R _____	_____
4. Lot No. _____, Recorded Plat _____		
5. Private Claims _____		

LIBER 28451 PAGE 496

Compliance with
ACT 345, P.A. 1990

APPROVED ON: 11-28-95 *DR.J.*
WAYNE COUNTY REMONUMENTATION
PEER GROUP COMMITTEE


Register of Deeds Stamp & File Number

I, Randy Kolehouse, in a field survey on September 7 19 94, do hereby certify that under requirements of P.A. 74 Michigan P.A. of 1970, the corner points mentioned in lines 1 and 2 above were in conformance with regulations and rules therefore as required in the current manual of survey instructions of the United States Department of the interior, Bureau of Land Management or by a decree of a Court of Law and/or that the corner points mentioned in lines 3, 4 and 5 above were in conformance with the rules of the Michigan Board of Land Surveyors or by a Decree of a Court of Law; established, re-established, monumented, re-monumented, recovered, found as expressed below:

NOTE: Not more than 4 corners, all in the same town and range, may be recorded on this certificate.

A. Description of original monument and accessories and/or subsequent restoration:

I-13	1817	G.L.O. Notes		Post
	1930's	WPA Notes	N/A	Iron
	1974	Cert. Survey L. 672 P. 500 M.C.R.D.	Stanley	N/A
	1974	WCRC Notes	N/A	Monument in Box

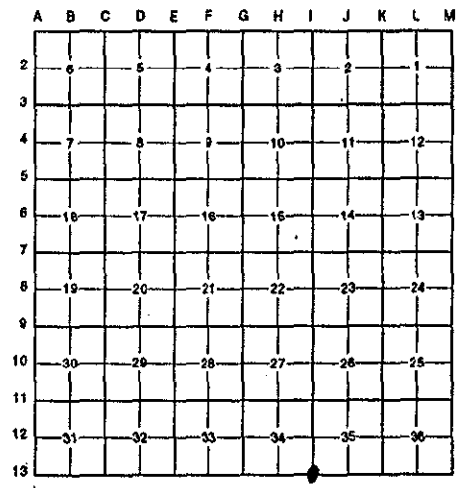

\$ 4.00 REMONUMENTATION
\$ 7.00 DEED
8 DEC 95 12:37 P.M. RECEIPT
RECORDED
FOREST E. YOUNGBLOOD, REGISTER
WAYNE COUNTY, MI

95262451

EDS

B. Description of corner evidence found and/or method applied in restoring or reestablishing corner:


I-13 Found concrete monument in monument box 7" ± below surface. Also found 1/2" pipe in C/L of Will Carleton Road (asphalt) running E-W 33.59' West of R.R. spike approximately NE corner, Section 3, T5S, R9E, which agrees with the following witnesses.

WPA	WCRC
8" Hickory SW'ly 61.72'	Nail w/Tag W Side 17" Tree NE 55.06' (54.93' m)
	Nail W Side 21" Oak SSW 65.08' (64.95' m)
Cert. Survey L. 672 P. 500 M.C.R.D.	Nail w/Tag NE Side D.E. Pole SSE 48.82' (48.78' m)
NW Cor. Sec. 2 T5S R9E East 33.85' (33.59' m)	
Measures East to K-13 = 5286.66' (G.L.O. = 5280') (WPA = 5278.66')	
Measures West to H-13 = 2629.95' (G.L.O. = 2640') (WPA = 2630.60')	

C. Description of monument for corner and accessories established to perpetuate locating the position of the corner:

-13 Replaced 1/2" pipe with 1/2" rebar with aluminum cap stamped "Wayne Co. Remon." in new monument box

- Nail w/Shinner NW Face 30" Hickory N 25° E 54.93'
 - Nail w/Tag "WCRC" NE Side Utl. Pole S 43° E 48.78'
 - Nail w/Shinner NE Face 34" Maple S 17° W 64.95'
 - Nail SE Face 10" Hickory S 49° W 61.60'
- NOT A COMMON CORNER**

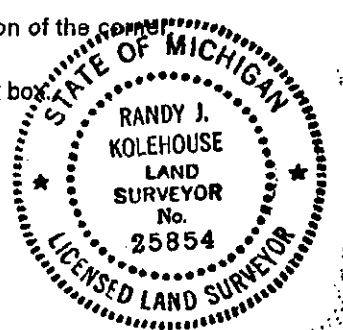

The selected location is accepted by the Contractor and is generally accepted by professional surveyors as the best available evidence of the position of the original corner.

Signed by Randy J. Kolehouse Date 12/2/95

Surveyor's Michigan License No. 25854

4R
7D
24