

DEC 21 1998

SURVEY & REMONUMENTATION

FILE DO NOT MAIL

LAND CORNER RECORDATION CERTIFICATE  
Filing Requirement of Act 74, Mich. P.A. 1970

MAR 02 1999

SECTION

For corners in

WAYNE (County)	Located in: Huron Township	Corner Code #
1. Public Land Survey	T 4S R 9E	J-11
	T R	
	T R	
	T R	
2. Property Controlling in Section	S T R	
	S T R	
3. Miscellaneous Property in Sec.	S T R	
	S T R	

Compliance with  
ACT 345, P.A. 1990

APPROVED ON: 12-15-98 *DBJ*

WAYNE COUNTY REMONUMENTATION  
PEER GROUP COMMITTEE

Register of Deeds Stamp & File Number

- 4. Lot No. \_\_\_\_\_, Recorded Plat \_\_\_\_\_
- 5. Private Claims \_\_\_\_\_

I, Bruce Antcliff, in a field survey on October 29 19 98, do hereby certify that under requirements of P.A. 74 Michigan P.A. of 1970, the corner points mentioned in lines 1 and 2 above were in conformance with regulations and rules therefore as required in the current manual of survey instructions of the United States Department of the Interior, Bureau of Land Management or by a decree of a Court of Law and/or that the corner points mentioned in lines 3, 4 and 5 above were in conformance with the rules of the Michigan Board of Land Surveyors or by a Decree of a Court of Law; established, re-established, monumented, re-monumented, recovered, found as expressed below:

NOTE: Not more than 4 corners, all in the same town and range, may be recorded on this certificate.

A. Description of original monument and accessories and/or subsequent restoration:

J-11	1. 1817	G.L.O.	Fletcher	Notes	Post
	2. 1930's	WPA Notes	N/A	Section Map and Ties	N/A
	3. 1948	H.C.M.A. Land Acquisition Map	N/A	N/A	N/A

B. Description of corner evidence found and/or method applied in restoring or reestablishing corner:

J-11 Found 1/2" rebar in a concrete monument on line of an old fence line running North and South and a tree row running East. Also found a 1' stone on the East side of monument.

- Set Nail w/W.C.R. Tag NE Side 12" Twin Oak S 53° E 2.88' (WPA = 3.08')
- Set Nail w/W.C.R. Tag W Side 30" Hickory S 05° W 38.09' (WPA = 38.70')
- Conc. Mon. N 05° E 78.25' (H.C.M.A. = 77.98')

\$7.00 DEED  
RECORDED  
FOREST E. YOUNGBLOOD, REGISTER OF DEEDS  
WAYNE COUNTY, MI  
Receipt #101302

- Measure West to I-11 = 2656.93' (WPA = 2655.98', 2656.98' & 2657.00')(G.L.O. = 2639.34')(H.C.M.A. = 2656.98')
- Measure East to calculated K-11 = 2645.33' (WPA = 2643.19')(G.L.O. = 2639.34')(H.C.M.A. = 2646.09' calc.)
- Measure South to J-12 = 2634.82' (H.C.M.A. = 2633.86')

C. Description of monument for corner and accessories established to perpetuate locating the position of the corner:


J-11 Set a 2" diameter aluminum cap stamped "Wayne Co. Remon. #25826" on an existing concrete monument. (Not in roadway.)

- Set Nail w/W.C.R. Tag S Side 12" Ash N 74° E 19.82'
- Set Nail w/W.C.R. Tag NE Side 12" Twin Oak S 53° E 2.88'
- Set Nail w/W.C.R. Tag W Side 30" Hickory S 05° W 38.09'
- Set Nail w/W.C.R. Tag S Side 8" Elm N 55° W 29.95'
- Conc. Mon. N 05° E 78.25'

The selected location is accepted by the Contractor and is generally accepted by professional surveyors as the best available evidence of the position of the original corner.

Signed by Bruce Antcliff Date 12-17-98

Surveyor's Michigan License No. 25826

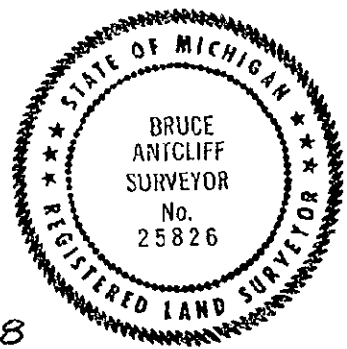

R LCR 7 4R 1PG U DBJ

Libert-30031  
Page-759.0  
12/21/1998 09:21AM