

LAND CORNER RECORDATION CERTIFICATE
Filing Requirement of Act 74, Mich. P.A. 1970

For corners in

Wayne <small>(County)</small>	Located In:	Corner Code #
1. Public Land Survey	T 4S R 9E	K-3
	T _____ R _____	_____
	T _____ R _____	_____
2. Property Controlling in Section	S _____ T _____ R _____	_____
	S _____ T _____ R _____	_____
3. Miscellaneous Property in Sec.	S _____ T _____ R _____	_____
	S _____ T _____ R _____	_____
4. Lot No. _____, Recorded Plat _____		
5. Private Claims _____		

LI 26951 PA 755

Compliance with
ACT 345, P.A. 1990

APPROVED ON: 10-28-93 ACQ
WAYNE COUNTY REMONUMENTATION
PEER GROUP COMMITTEE
Register of Deeds Stamp & File Number

RC 1124

I, Bruce Antcliff, in a field survey on August 18, 19 93, do hereby certify that under requirements of P.A. 74, Michigan P.A. of 1970, the corner points mentioned in lines 1 and 2 above were in conformance with regulations and rules therefore as required in the current manual of survey instructions of the United States Department of the Interior, Bureau of Land Management or by a decree of a Court of Law and/or that the corner points mentioned in lines 3, 4 and 5 above were in conformance with the rules of the Michigan Board of Land Surveyors or by a Decree of a Court of Law, established, re-established, monumented, re-monumented, recovered, found as expressed below:

A	B	C	D	E	F	G	H	I	J	K	L	M
2	6	5	4	3	2							
3												
4	7	8	9	10	11	12						
5												
6	18	17	16	15	14	13						
7												
8	19	20	21	22	23	24						
9												
10	30	29	28	27	26	25						
11												
12	31	32	33	34	35	36						
13												

NOTE: Not more than 4 corners, all in the same town and range, may be recorded on this certificate.

A. Description of original monument and accessories and/or subsequent restoration:

- GLO-Post
- WPA (1930's) - Iron
- LCRC (1976)-1/2 Pipe in Mon. Box (L19608, P 464)
- LCRC (1976)-Iron in Mon. Box (L19472, P 768)

B. Description of corner evidence found and/or method applied in restoring or reestablishing corner:

Conc. Mon. in Mon. Box; Measured to W 1/4 S.1, S 1/4 S.1 and SW S.2-all checked well w/WPA Surveys.

C. Description of monument for corner and accessories established to perpetuate locating the position of the corner:


Set Wayne County Remonumentation Marker and Cap #25826 on exist monument

Witnesses

- Nail and WCRC Tag NE Face P.P., NW, 78.42'
- Nail and WCRC Tag NW Face MBT Pole, SW, 49.42'
- P.K. SW Face MBT Pole, SE, 45.82'
- SW Cor. Bldg., NE, 133.98'

The selected location is accepted by the Contractor and is generally accepted by professional surveyors as the best available evidence of the position of the original corner.

Signed by Bruce Antcliff Date 11-10-93
Surveyor's Michigan License No. 25826

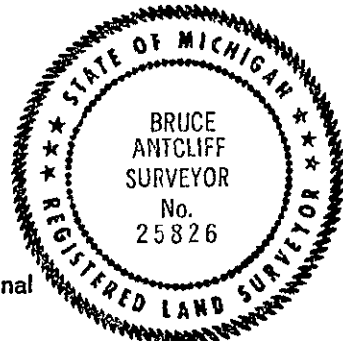

53 NOV 10 PM 2:27
FOREST & TREES
REGISTERED DEEDS
WAYNE COUNTY MI

PK 110