

FILE DO NOT MAIL

LAND CORNER RECORDATION CERTIFICATE REMONUMENTATION
Filing Requirement of Act 74, Mich. P.A. 1970

MAR 17 1998


For corners in

WAYNE (County)	Located in: Huron Township	Corner Code #
1. Public Land Survey	T <u>4S</u> R <u>9E</u>	<u>K-4</u>
	T _____ R _____	_____
	T _____ R _____	_____
	T _____ R _____	_____
2. Property Controlling in Section	S _____ T _____ R _____	_____
	S _____ T _____ R _____	_____
3. Miscellaneous Property in Sec.	S _____ T _____ R _____	_____
	S _____ T _____ R _____	_____

SECTION
Compliance with
ACT 345, P.A. 1990
APPROVED ON: 12-1-97 *DPJ*
WAYNE COUNTY REMONUMENTATION
PEER GROUP COMMITTEE
Register of Deeds Stamp & File Number

4. Lot No. _____, Recorded Plat _____
5. Private Claims _____

I, Randy Kolehouse, in a field survey on November 8 19 97, do hereby certify that under requirements of P.A. 74 Michigan P.A. of 1970, the corner points mentioned in lines 1 and 2 above were in conformance with regulations and rules therefore as required in the current manual of survey instructions of the United States Department of the interior, Bureau of Land Management or by a decree of a Court of Law and/or that the corner points mentioned in lines 3, 4 and 5 above were in conformance with the rules of the Michigan Board of Land Surveyors or by a Decree of a Court of Law; established, re-established, monumented, re-monumented, recovered, found as expressed below:

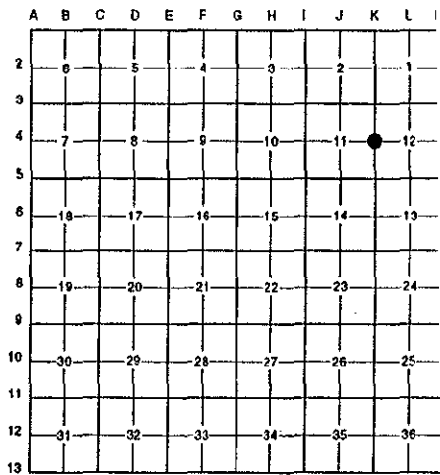

NOTE: Not more than 4 corners, all in the same town and range, may be recorded on this certificate.

A. Description of original monument and accessories and/or subsequent restoration:

K-4	1. 1817	G.L.O.	Fletcher	Notes	Post
	2. 1930's	WPA Notes	N/A	Section Map and Ties	Iron
	3. 1972	Cert. Survey	Andrus #17609	L. 18234 P. 837-838	N/A
	4. 1973	W.C.R.C.	N/A	Witness Record	Iron in Box
	5. 1974	L.C.R.C.	Crossman #9428	L. 18922 P. 53	Mon. in Hand Hole

\$7.00 DEED
\$4.00 REMONUMENTATION

B. Description of corner evidence found and/or method applied in restoring or reestablishing corner:

K-4 Found a concrete monument in a monument box at the C/L intersection of Middlebelt Road (asph.) running North and South and Bredow Road (gravel) running East per the following witnesses:
Fnd. PK SW face util pole, M= S42E 35.80, R= 36.18' (4): Set nail w/WCR tag E face 24" Oak, M= S23W 133.59', R= 133.72' to nail SE side 18" oak (4): Fnd. PK w/WCRC tag S face util pole, M= N53W 34.94', R= 34.95' (4), 35.94' (5).

NOTE: WPA shows another corner 12.45' north for the E1/4 corner of Section 11. The Andrus survey used this corner but shows no ties or witnesses. Since all other use is to the found monument in mon box, I used this as the corner. The theoretical point 12.45' north will be used as a property controlling corner.


Measure North to K-3 = 2625.62' (W.P.A. = 2625.24') (G.L.O. = 2640.0')
Measure South to K-5 = 2579.67' (W.P.A. = 2579.32') (G.L.O. = 2640.0')

RECORDED
FOREST E. YOUNGBLOOD, REGISTER OF DEED
WAYNE COUNTY, MI
Receipt #43169

C. Description of monument for corner and accessories established to perpetuate locating the position of the corner:

K-4 Set a 2" diameter aluminum cap stamped "Wayne Co. Remon. #25854" on the existing 4" x 36" concrete monument in an existing monument box.

P.K. Nail in NE Face Util. Pole S 42° E 35.59'
P.K. in SW Face util. Pole S 42° E 35.80'
Nail w/W.C.R. Tag in E Face 24" Oak S 23° W 133.59'
P.K. Nail w/W.C.R.C. Tag in S Face Util. Pole N 55° W 34.94'
C/L Top Nut Hydrant N 06° W 167.82'

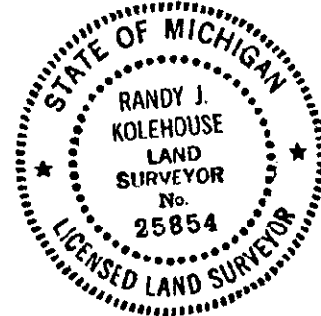

The selected location is accepted by the Contractor and is generally accepted by professional surveyors as the best available evidence of the position of the original corner.

Signed by Randy J. Kolehouse Date 12/16/97
Surveyor's Michigan License No. 25854