

SURVEY & REMONUMENTATION

RC 1125

DEC 02 1993

LI 26951 PA 756

LAND CORNER RECORDATION CERTIFICATE
Filing Requirement of Act 74, Mich. P.A. 1970

For corners in COMMISSION

Wayne (County) Located In: Corner Code #
1. Public Land Survey T 4S R 9E K-7
2. Property Controlling in Section S T R
3. Miscellaneous Property in Sec. S T R
4. Lot No. , Recorded Plat
5. Private Claims

Compliance with ACT 345, P.A. 1990
APPROVED ON: 10-28-93
WAYNE COUNTY REMONUMENTATION PEER GROUP COMMITTEE
Register of Deeds Stamp & File Number

RC 1125

I, Bruce Antcliff, in a field survey on August 19, 1993, do hereby certify that under requirements of P.A. 74, Michigan P.A. of 1970, the corner points mentioned in lines 1 and 2 above were in conformance with regulations and rules therefore as required in the current manual of survey instructions of the United States Department of the Interior, Bureau of Land Management or by a decree of a Court of Law and/or that the corner points mentioned in lines 3, 4 and 5 above were in conformance with the rules of the Michigan Board of Land Surveyors or by a Decree of a Court of Law; established, re-established, monumented, re-monumented, recovered, found as expressed below:

Grid table with columns A-M and rows 1-13. A dot is present at the intersection of column J and row 7.

NOTE: Not more than 4 corners, all in the same town and range, may be recorded on this certificate.

A. Description of original monument and accessories and/or subsequent restoration:

GLO-Post
WPA (1930's) - Iron
LCRC (1975)-Mon. in Box (L19245, P 602)
LCRC (1989)-Mon. in Box (L24096, P 729)

B. Description of corner evidence found and/or method applied in restoring or reestablishing corner:

Conc. Mon. in Mon. Box; Measured to NW S.23 and E 1/4 S.23- checked well w/WPA Surveys.

C. Description of monument for corner and accessories established to perpetuate locating the position of the corner:

Set Wayne County Remonumentation Marker and Cap #25826 on exist monument

Witnesses


P.K. SW Face MBT Pole, NW, 52.34'
Nail and WCRC Tag E. Face P.P., SW, 44.05'
P.K. N. Face P.P., ESE, 118.65'
P.K. NW Face MBT Pole, NE, 41.23'

The selected location is accepted by the Contractor and is generally accepted by professional surveyors as the best available evidence of the position of the original corner.

Signed by Bruce Antcliff 25826

Date 11-10-93

Surveyor's Michigan License No.

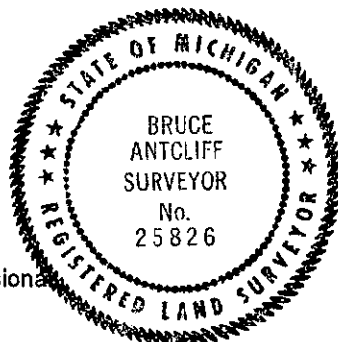

93 NOV 10 PM 2:27
