

**SURVEY &
REMONUMENTATION**

RC 1127

DEC 02 1993

**LAND CORNER RECORDATION CERTIFICATE
Filing Requirement of Act 74, Mich. P.A. 1970**

LI 26951 PA 758

For corners in **COMMISSION**

<u>Wayne</u> <small>(County)</small>	Located In:	Corner Code <u>##</u>
1. Public Land Survey	T <u>4S</u> R <u>9E</u>	<u>K-12</u>
	T _____ R _____	_____
	T _____ R _____	_____
	T _____ R _____	_____
2. Property Controlling in Section	S _____ T _____ R _____	_____
	S _____ T _____ R _____	_____
3. Miscellaneous Property in Sec.	S _____ T _____ R _____	_____
	S _____ T _____ R _____	_____
4. Lot No. _____, Recorded Plat _____		
5. Private Claims _____		

Compliance with
ACT 345, P.A. 1990

APPROVED ON: 10-28-93 YCAO
WAYNE COUNTY REMONUMENTATION
PEER GROUP COMMITTEE

Register of Deeds Stamp & File Number

RC 1127

I, Bruce Antcliff, in a field survey on August 20, 1993, do hereby certify that under requirements of P.A. 74, Michigan P.A. of 1970, the corner points mentioned in lines 1 and 2 above were in conformance with regulations and rules therefore as required in the current manual of survey instructions of the United States Department of the Interior, Bureau of Land Management or by a decree of a Court of Law and/or that the corner points mentioned in lines 3, 4 and 5 above were in conformance with the rules of the Michigan Board of Land Surveyors or by a Decree of a Court of Law; established, re-established, monumented, re-monumented, recovered, found as expressed below:

NOTE: Not more than 4 corners, all in the same town and range, may be recorded on this certificate.

	A	B	C	D	E	F	G	H	I	J	K	L	M
2	6		5		4		3		2		1		
3													
4	7		8		9		10		11		12		
5													
6	18		17		16		15		14		13		
7													
8	19		20		21		22		23		24		
9													
10	30		29		28		27		26		25		
11													
12	31		32		33		34		35		36		
13													

A. Description of original monument and accessories and/or subsequent restoration:

GLO-Post
WPA (1930's) - Iron

B. Description of corner evidence found and/or method applied in restoring or reestablishing corner:

Conc. Mon. on north side fence corner-Measured to SE Cor. S.35; Checked well with WPA Surveys and Survey for Country Meadows Mobile Home Park

93 NOV 10 PM 2:27
STATE OF MICHIGAN


C. Description of monument for corner and accessories established to perpetuate locating the position of the corner:

Set Wayne County Remonumentation Marker and Cap #25826 on exist monument

Witnesses

- P.K. SW Face 15" Oak, NW, 85.57'
- P.K. N. Face N'Most tree in group of six 6" Thom Apples, SE, 8.24'
- P.K. N. Face 6" Tree, East, 31.50'
- P.K. SW Face 10" Twin Maple, NE, 83.67'

The selected location is accepted by the Contractor and is generally accepted by professional surveyors as the best available evidence of the position of the original corner.

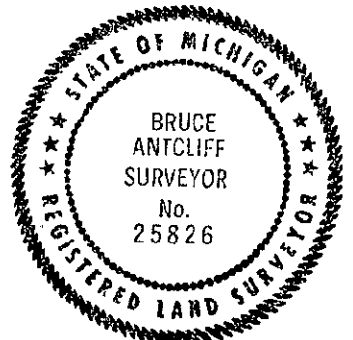

Signed by Bruce Antcliff 25826
Surveyor's Michigan License No. _____

Date 11-10-93

Life