

SURVEY & REMONUMENTATION

APR 25 1995

RC 1593

COMMISSION

LAND CORNER RECORDATION CERTIFICATE
Filing Requirement of Act 74, Mich. P.A. 1970

L27800PA660

For corners in

<u>WAYNE</u> (County)	Located in: Huron Township	Corner Code #
1. Public Land Survey	T <u>4S</u> R <u>9E</u>	<u>M-1</u>
	T _____ R _____	_____
	T _____ R _____	_____
	T _____ R _____	_____
2. Property Controlling in Section	S _____ T _____ R _____	_____
	S _____ T _____ R _____	_____
3. Miscellaneous Property in Sec.	S _____ T _____ R _____	_____
	S _____ T _____ R _____	_____

Compliance with
ACT 345, P.A. 1990


APPROVED ON: 12-7-94 *[Signature]*

WAYNE COUNTY REMONUMENTATION
PEER GROUP COMMITTEE

Register of Deeds Stamp & File Number

RC 1593

4. Lot No. _____, Recorded Plat _____
5. Private Claims _____

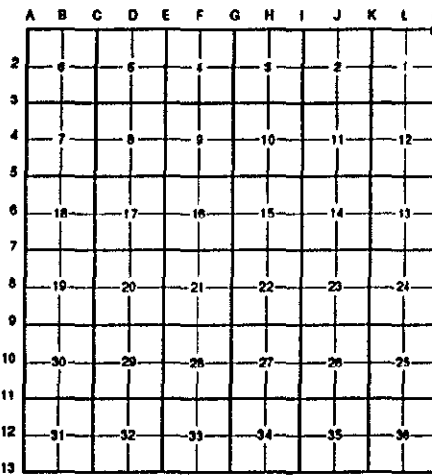

I, Randy Kolehouse, in a field survey on July 28 19 94, do hereby certify that under requirements of P.A. 74 Michigan P.A. of 1970, the corner points mentioned in lines 1 and 2 above were in conformance with regulations and rules therefore as required in the current manual of survey instructions of the United States Department of the Interior, Bureau of Land Management or by a decree of a Court of Law and/or that the corner points mentioned in lines 3, 4 and 5 above were in conformance with the rules of the Michigan Board of Land Surveyors or by a Decree of a Court of Law; established, re-established, monumented, re-monumented, recovered, found as expressed below:

NOTE: Not more than 4 corners, all in the same town and range, may be recorded on this certificate.

A. Description of original monument and accessories and/or subsequent restoration:

M-1	1817	G.L.O. Notes	N/A	Post
	1930's	WPA Notes	N/A	Stone
	1976	WCRC Notes	N/A	Iron in Mon. Box

B. Description of corner evidence found and/or method applied in restoring or reestablishing corner:

M-1 I found 1" pipe w/P.K. in C/L, set in concrete in monument box, at the C/L intersection of Pennsylvania running N-S and Inkster running E-W. This iron checks dist. as shown in WPA Survey. OK E-W & -0.28' South. No witnesses remain.

\$ 13.00 MISCELLANEOUS RECORDING
28 DEC 94 9:40 A.M. RECEIPT# 165
RECORDED
FOREST E. YOUNGLOO, REGISTER OF DEEDS
WAYNE COUNTY, MI


WCRC
Nail w/Tag "WCRC" SE Side D.E. Co. Pole NE 83.12' (83.20' m)
Nail w/Tag "WCRC" SW Side D.E. Co. Pole NW 59.46' (59.39' m)
Nail w/Tag "WCRC" SW Side MBT Co. Pole SE 49.79' (49.40' m)

Measures West to L-1 = 2639.22' (G.L.O. = 2640') (WPA = 2639.21')
Measures South to M-2 = 2638.06' (G.L.O. = 2640') (WPA = 2638.34')

C. Description of monument for corner and accessories established to perpetuate locating the position of the corner:

M-1 I set a 1/2" rebar and aluminum cap stamped "Wayne Co. Remon." inside existing 1" pipe in an existing monument box.

P.K. w/Tag "WCRC" SE Face Util. Pole N 55° E 83.20'
P.K. w/Tag "O" HMKSW #21584" SW Face Util. Pole S 28° E 49.96'
P.K. in Top of Guard Rail Post, 5th N of S End S 49° W 48.16'
P.K. w/Tag "WCRC" SW Face Util. Pole N 28° W 59.39'

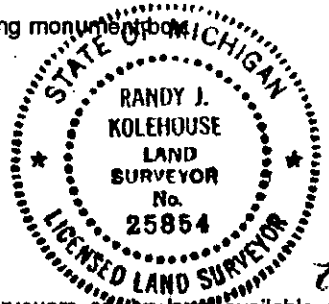

The selected location is accepted by the Contractor and is generally accepted by professional surveyors as the best available evidence of the position of the original corner.

Signed by Randy J. Kolehouse Date 12/14/94
Surveyor's Michigan License No. 25854