

LAND CORNER RECORDATION CERTIFICATE
Filing Requirement of Act 74, Mich. P.A. 1970

\$ 4.00 REMONUMENTATION
 \$ 10.00 DEED

26 DEC 96 12:42 P.M. RECEIVED
 RECORDED
 FOREST E. YOUNGBLOOD, REGISTER
 WAYNE COUNTY, MI

A
 EDS

For corners in

WAYNE
 (County)

Located in: Huron
 Township

Corner Code #

- | | | | |
|---------------------------------------|-------------|-------------|------------|
| 1. Public Land Survey | T <u>4S</u> | R <u>9E</u> | <u>M-4</u> |
| | T _____ | R _____ | _____ |
| | T _____ | R _____ | _____ |
| | T _____ | R _____ | _____ |
| 2. Property Controlling in Section | S _____ | T _____ | R _____ |
| | S _____ | T _____ | R _____ |
| 3. Miscellaneous Property in Sec. | S _____ | T _____ | R _____ |
| | S _____ | T _____ | R _____ |
| 4. Lot No. _____, Recorded Plat _____ | | | |
| 5. Private Claims _____ | | | |

LI29360PA575

Compliance with
 ACT 345, P.A. 1990

APPROVED ON: DEC 17, 1996
 WAYNE COUNTY REMONUMENTATION
 PEER GROUP COMMITTEE
 Register of Deeds Stamp & File Number

96326791

I, Randy Kolehouse, in a field survey on December 4 19 96, do hereby certify that under requirements of P.A. 74 Michigan P.A. of 1970, the corner points mentioned in lines 1 and 2 above were in conformance with regulations and rules therefore as required in the current manual of survey instructions of the United States Department of the interior, Bureau of Land Management or by a decree of a Court of Law and/or that the corner points mentioned in lines 3, 4 and 5 above were in conformance with the rules of the Michigan Board of Land Surveyors or by a Decree of a Court of Law; established, re-established, monumented, re-monumented, recovered, found as expressed below:

A	B	C	D	E	F	G	H	I	J	K	L
2	6	5	4	3	2	1					
3											
4	7	8	9	10	11	12					
5											
6	18	17	16	15	14	13					
7											
8	19	20	21	22	23	24					
9											
10	30	29	28	27	26	25					
11											
12	31	32	33	34	35	36					
13											

NOTE: Not more than 4 corners, all in the same town and range, may be recorded on this certificate.

A. Description of original monument and accessories and/or subsequent restoration:

M-4	1817	G.L.O.	Fletcher	Notes	Post
	1930's	WPA Notes	N/A	Section Map and Ties	Iron
	1953	D.E. Co. Survey	N/A	N/A	Iron

Records indicate this corner is not common with A-4 T4S R10E.

(Continued on Back)

B. Description of corner evidence found and/or method applied in restoring or reestablishing corner:

M-4 Found a 1/2" rebar in a monument box in the C/L intersection of Inkster Road (asphalt) running North and South and Bredow Road (gravel) running West 62.12' North of A-4 T4S R10E per WPA witnesses. This point also checks the following witnesses:

WPA Notes (1930's)	L.C.R.C. L. 20534 P. 780 (1979)
Tele. Pole SE 33.23' (m. 33.61')	Nail & Tag NE Side D.E. Pole WNW 60.77' (m. 60.87')
W 1/4 Sec. 7 T4S R10E S 62.10' (m. 62.12')	Nail & Tag SW Side 22" Oak NW 58.90'
E.D. Pole WNW 62.50' (m. 62.12')	Nail & Washer W. Side MBT Pole NE 90.15' (m. 90.04')
15" Oak NW 58.19' (m. 58.09')	Nail & Tag N Side MBT Pole SE 33.75' (m. 33.61')
	Conc. Mon. in Box W 1/4 Sec. 7 T4S R10E S 62.05' (m. 62.12')

D.E. Co. Survey (1953)	W.C.R.C. Witness Record (1981)
MBT Pole SE 33.23' (m. 33.61')	C/L Hydrant NE 101.03' (101.15')
Iron S 62.10' (m. 62.12')	W.C.R.C. Nail & Tag SW Side MBT Pole SE 33.75' (m. 33.61')
15" Oak NW 58.19' (58.09')	1" Iron S 62.09' (m. 62.12')
	W.C.R.C. Nail & Tag N Face D.E. Pole WNW 60.76' (m. 60.87')
	W.C.R.C. Nail & Tag S Face 22" Oak NW 58.91' (m. 58.09')


Measure North to M-3 = 2648.29' (WPA = 2648.44') (G.L.O. = 2640.0') (W.C. Records = 2648.03')
 Measure South to M-5 = 2677.93' (WPA = 2678.12') (G.L.O. = 2640.0')

C. Description of monument for corner and accessories established to perpetuate locating the position of the corner:

M-4 Set brass "Wayne Co. Remon." disk and survey cap #25854 on existing 1/2" rebar in an existing monument box.	
P.K. Nail w/Washer in W Side Util. Pole N 22° E 90.04'	Nail & Shiner in S Side P. Pole N 53° W 60.84'
Top Nut of Hydrant N 33° E 101.15'	Nail w/W.C.R.C. Tag in NE Side P. Pole N 53° W 60.87'
Nail w/W.C.R.C. Tag in NE Side MBT Pole S 45° E 33.61'	Nail & Shiner in E Side 24" Oak N 23° W 58.09'
Nail & Shiner in SW Side MBT Pole S 45° E 33.65'	

The selected location is accepted by the Contractor and is generally accepted by professional surveyors as the best available evidence of the position of the original corner.

Signed by Randy J Kolehouse Date 12/24/96
 Surveyor's Michigan License No. 25854

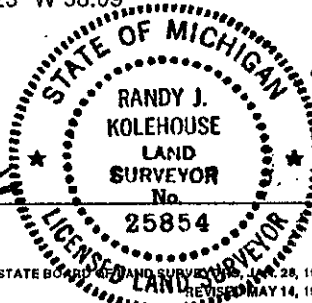

Part A (Continued)

1973	W.C.R.C.	Coon	Witness Record	1" Iron
1974	W.C.R.C.	Lopota	Witness Record	Iron Pipe
1976	W.C.R.C.	Golis	Witness Record	3/4" Iron Pipe
1976	Cert. Survey	Arthurs #11358	L. 19472 P. 783	I.P. Stake
1978	L.C.R.C.	Arthurs #11358	L. 20074 P. 307	I.P. Stake
1978	Cert. Survey	Arthurs #11358	L. 20074 P. 302-305	I.P. Stake
1979	L.C.R.C.	Swanson	L. 20534 P. 780	3/4" Iron Pipe
1979	W.C.R.C.	???	Witness Record	Conc. Mon. in Mon. Box
1981	W.C.R.C.	Golis	Witness Record	3/4" Iron Pipe