

SURVEY & REMONUMENTATION

RC 1596

APR 25 1995

COMMISSION

**LAND CORNER RECORDATION CERTIFICATE
Filing Requirement of Act 74, Mich. P.A. 1970**

For corners in

| | | |
|---------------------------------------|-------------------------------|-----------------------------|
| <u>WAYNE</u> (County) | Located in: Huron Township | Corner Code # <u>M-9</u> |
| 1. Public Land Survey | T <u>4S</u> R <u>9E</u> | <u>M-9</u> |
| | T _____ R _____ | _____ |
| | T _____ R _____ | _____ |
| | T _____ R _____ | _____ |
| 2. Property Controlling In Section | S _____ T _____ R _____ | _____ |
| | S _____ T _____ R _____ | _____ |
| 3. Miscellaneous Property In Sec. | S _____ T _____ R _____ | _____ |
| | S _____ T _____ R _____ | _____ |

L127800PA663

Compliance with
ACT 345, P.A. 1990

APPROVED ON: 12-7-94 *DRJ*
WAYNE COUNTY REMONUMENTATION
PEER GROUP COMMITTEE

Register of Deeds Stamp & File Number

RC 1596

4. Lot No. _____, Recorded Plat _____
5. Private Claims _____

I, Randy Kolehouse, in a field survey on August 24 19 93, do hereby certify that under requirements of P.A. 74 Michigan P.A. of 1970, the corner points mentioned in lines 1 and 2 above were in conformance with regulations and rules therefore as required in the current manual of survey instructions of the United States Department of the Interior, Bureau of Land Management or by a decree of a Court of Law and/or that the corner points mentioned in lines 3, 4 and 5 above were in conformance with the rules of the Michigan Board of Land Surveyors or by a Decree of a Court of Law; established, re-established, monumented, re-monumented, recovered, found as expressed below:

| | | | | | | | | | | | |
|----|----|----|----|----|----|----|---|---|---|---|---|
| A | B | C | D | E | F | G | H | I | J | K | L |
| 2 | 6 | 5 | 4 | 3 | 2 | 1 | | | | | |
| 3 | | | | | | | | | | | |
| 4 | 7 | 8 | 9 | 10 | 11 | 12 | | | | | |
| 5 | | | | | | | | | | | |
| 6 | 18 | 17 | 16 | 15 | 14 | 13 | | | | | |
| 7 | | | | | | | | | | | |
| 8 | 19 | 20 | 21 | 22 | 23 | 24 | | | | | |
| 9 | | | | | | | | | | | |
| 10 | 30 | 29 | 28 | 27 | 26 | 25 | | | | | |
| 11 | | | | | | | | | | | |
| 12 | 31 | 32 | 33 | 34 | 35 | 36 | | | | | |
| 13 | | | | | | | | | | | |

NOTE: Not more than 4 corners, all in the same town and range, may be recorded on this certificate.

A. Description of original monument and accessories and/or subsequent restoration:

| | | | | |
|-----|--------|--------------------------|-----|-------------------|
| M-9 | 1817 | G.L.O. Notes | N/A | Post |
| | 1930's | WPA Notes | N/A | Iron |
| | 1974 | L.C.R.C. L. 18956 P. 720 | N/A | Iron Pipe |
| | 1978 | L.C.R.C. L. 20098 P. 249 | N/A | Concrete Monument |

B. Description of corner evidence found and/or method applied in restoring or reestablishing corner:

M-9 Found concrete monument in monument box in the C/L intersection of Inkster Road (asphalt) running N-S and Van Horn Road running E-W. Cannot remove cover, hole broken in cover for access to monument.


Checks dist. N 1/4 corner (L-9) and NW corner (K-9) Section 25 per WPA surveys.

\$ 13.00 MISCELLANEOUS RECORDING
28 DEC 94 9:40 A.M. RECEIPT# 250
RECORDED
FOREST E. YOUNGBLOOD, REGISTER OF DEEDS
WAYNE COUNTY, MI

C. Description of monument for corner and accessories established to perpetuate locating the position of the corner:

M-9 Set a Wayne County Remonumentation Marker and Cap on existing monument in monument box.

- P.K. NE Face of Guy Pole N 24° W 67.35'
- P.K. NE Face of Guy Pole N 54° W 62.30'
- Nail and Shiner NE Face P. Pole S 57° W 54.33'
- Nail and Shiner N Face P. Pole S 40° E 44.67'

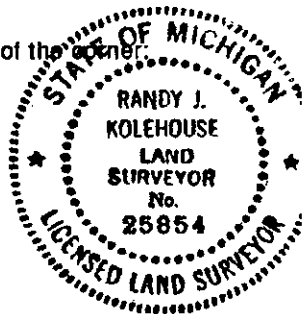

The selected location is accepted by the Contractor and is generally accepted by professional surveyors as the best available evidence of the position of the original corner.

Signed by Randy J. Kolehouse Date 12/14/94
Surveyor's Michigan License No. 25854