

LAND CORNER RECORDATION CERTIFICATE
Filing Requirement of Act 74, Mich. P.A. 1970

LI29360PA581

For corners in


<u>WAYNE</u> (County)	Located in: Brownstown Township	Corner Code # _____
1. Public Land Survey	T <u>4S</u> R <u>10E</u>	<u>B-7</u>
	T _____ R _____	_____
	T _____ R _____	_____
	T _____ R _____	_____
2. Property Controlling in Section	S _____ T _____ R _____	_____
	S _____ T _____ R _____	_____
3. Miscellaneous Property in Sec.	S _____ T _____ R _____	_____
	S _____ T _____ R _____	_____
4. Lot No. _____, Recorded Plat _____		
5. Private Claims _____		

Compliance with
ACT 345, P.A. 1990 *DBJ*

APPROVED ON: DEC. 17, 1996
WAYNE COUNTY REMONUMENTATION
PEER GROUP COMMITTEE
 Register of Deeds Stamp & File Number

96326796

I, Randy Kolehouse, in a field survey on December 5 19 96, do hereby certify that under requirements of P.A. 74 Michigan P.A. of 1970, the corner points mentioned in lines 1 and 2 above were in conformance with regulations and rules therefore as required in the current manual of survey instructions of the United States Department of the interior, Bureau of Land Management or by a decree of a Court of Law and/or that the corner points mentioned in lines 3, 4 and 5 above were in conformance with the rules of the Michigan Board of Land Surveyors or by a Decree of a Court of Law; established, re-established, monumented, re-monumented, recovered, found as expressed below:

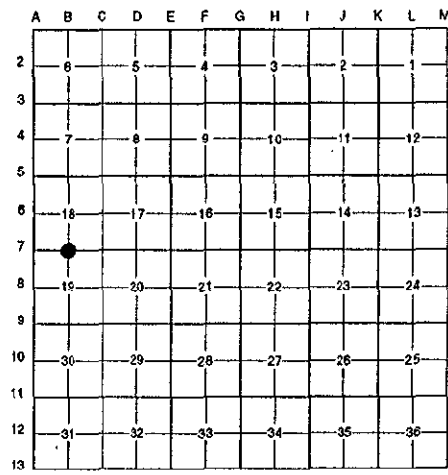

NOTE: Not more than 4 corners, all in the same town and range, may be recorded on this certificate.

A. Description of original monument and accessories and/or subsequent restoration:

B-7	1817	G.L.O.	Fletcher	Notes
	1930's	WPA Notes	N/A	Section Map and Ties
	1973	W.C.R.C.	Coon	Witness Record
	1974	Cert. Survey	Ayers #4615	L. 20363 P. 195-196

\$ 4.00 REMONUMENTATION
 4.00 DEED
 12:43 P.M. RECEI A
 IRON RECORDED
 E. YOUNGBLOOD, REGISTER ED5
 WAYNE COUNTY, MI

B. Description of corner evidence found and/or method applied in restoring or reestablishing corner:

B-7 Found a 1/2" rebar in a monument box in the C/L of West Road (asphalt) running East & West. No WPA witnesses remain. No W.C.R.C. witnesses remain. Cert. Survey prepared by Ayers recorded in L. 20363 P. 195 shows no witnesses to this corner.

Measure West to A-7 2657.83' (WPA = 2657.87') (G.L.O. = 2689.5')
 Measure East to C-7 2649.62' (WPA = 2649.86') (G.L.O. = 2640.0') (Survey L. 20363 P. 195 = 2649.38')

C. Description of monument for corner and accessories established to perpetuate locating the position of the corner:

B-7 Set brass "Wayne Co. Remon." disk and survey cap #25854 on existing 1/2" rebar in an existing monument box.

- P.K. Nail in SW Side 24" Oak N 59° E 92.25'
- P.K. Nail in SE Side 24" Oak N 59° E 93.40'
- Top Nut Hydrant S 67° E 162.64'
- Nail w/W.C.R.C. Tag in E Side P. Pole S 12° W 53.40'
- P.K. Nail in NW Side P. Pole S 12° W 52.87'
- "+" in SE Rim Sanitary M/H N 51° W 89.88'
- Nail w/W.C.R.C. Tag in E Side P. Pole N 15° E 49.25'

The selected location is accepted by the Contractor and is generally accepted by professional surveyors as the best available evidence of the position of the original corner.



4R
70
DBJ

Signed by Randy J. Kolehouse Date 12/24/96
 Surveyor's Michigan License No. 25854