

SURVEY & REMONUMENTATION

DEC 0 2 1993

RC 1097

LI 26951 PA 718

COMMISSION

LAND CORNER RECORDATION CERTIFICATE
Filing Requirement of Act 74, Mich. P.A. 1970

For corners in

Wayne (County)	Located in:	Corner Code #
1. Public Land Survey	T <u>4S</u> R <u>10E</u>	<u>B-9</u>
	T _____ R _____	_____
	T _____ R _____	_____
	T _____ R _____	_____
2. Property Controlling in Section	S _____ T _____ R _____	_____
	S _____ T _____ R _____	_____
3. Miscellaneous Property in Sec.	S _____ T _____ R _____	_____
	S _____ T _____ R _____	_____

Compliance with
ACT 345, P.A. 1990
 APPROVED ON: 10-28-93
WAYNE COUNTY REMONUMENTATION
PEER GROUP COMMITTEE

Register of Deeds Stamp & File Number

4. Lot No. _____, Recorded Plat _____
 5. Private Claims _____

I, Bruce Antcliff, in a field survey on October 4, 19 93, do hereby certify that under requirements of P.A. 74, Michigan P.A. of 1970, the corner points mentioned in lines 1 and 2 above were in conformance with regulations and rules therefore as required in the current manual of survey instructions of the United States Department of the Interior, Bureau of Land Management or by a decree of a Court of Law and/or that the corner points mentioned in lines 3, 4 and 5 above were in conformance with the rules of the Michigan Board of Land Surveyors or by a Decree of a Court of Law; established, re-established, monumented, re-monumented, recovered, found as expressed below:

NOTE: Not more than 4 corners, all in the same town and range, may be recorded on this certificate.

A. Description of original monument and accessories and/or subsequent restoration:

- GLO-Post
- WPA (1930's) - Iron
- LCRC (8-74) Conc. Mon. (L 18932, P 681)
- LCRC (9-74) Iron Rod (L 18956, P 722)
- WWES (1991) Conc. Mon.

B. Description of corner evidence found and/or method applied in restoring or reestablishing corner:

Found Conc. Mon.; Verified one witness from LCRC. Checked distance to NW & NE Cor. Sec. 30. Distances checked well with WPA Survey.

C. Description of monument for corner and accessories established to perpetuate locating the position of the corner:

Set Wayne County Remonumentation Marker and Cap #25826 on existing monument.


Witnesses

- Chisled "+" nearest side Sanitary MH, NNW, 29.30'
- P.K. Nail W. face 6" Fruit Tree, NNE, 52.84'
- P.K. Nail S'y face 18" Sycamore, ENE, 79.79'
- Chisled "+" N. end 3' dia. rock, South, 58.25'
- WCRC Nail & Tag W. side P.P., SW, 41.49'

The selected location is accepted by the Contractor and is generally accepted by professional surveyors as the best available evidence of the position of the original corner.

Signed by Bruce Antcliff
 Surveyor's Michigan License No. 25826

Date 11-10-93

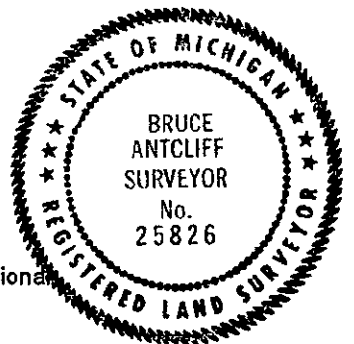

RC 1097

 93 NOV 10 PM 2:15