

FILE DO NOT MAIL

LAND CORNER RECORDATION CERTIFICATE
Filing Requirement of Act 74, Mich. P.A. 1970
Liber-29739

Page-580.0
97327860LS 12/15/1997 08:47AM

For corners in

WAYNE
(County)

Located in: CITY OF TAYLOR (TOWNSHIP #14)

- 1. Public Land Survey TO T3S R10E C-13
- 2. Property Controlling in Section S T R
- 3. Miscellaneous Property in Sec. S T R
- 4. Lot No. _____, Recorded Plat _____
- 5. Private Claims _____

Compliance with
ACT 345, P.A. 1990

APPROVED ON: 11-13-97
WAYNE COUNTY REMONUMENTATION
PEER GROUP COMMITTEE

Register of Deeds Stamp & File Number


MAR 17 1998

SECTION

A	B	C	D	E	F	G	H	I	J	K	L	M
2	6	5	4	3	2	1						
3												
4	7	8	9	10	11	12						
5												
6	18	17	15	15	14	13						
7												
8	19	20	21	22	23	24						
9												
10	30	29				26	25					
11												
12	31	32				36						
13												

I, WALTER J. ZBIKOWSKI, in a field survey on NOVEMBER 25, 1997, do hereby certify that under requirements of P.A. 74, Michigan P.A. of 1970, the corner points mentioned in lines 1 and 2 above were in conformance with regulations and rules therefore as required in the current manual of survey instructions of the United States Department of the Interior, Bureau of Land Management or by a decree of a Court of Law and/or that the corner points mentioned in lines 3, 4 and 5 above were in conformance with the rules of the Michigan Board of Land Surveyors or by a Decree of a Court of Law; established, re-established, monumented, re-monumented, recovered, found as expressed below.

NOTE: Not more than 4 corners, all in the same town and range, may be recorded on this certificate.

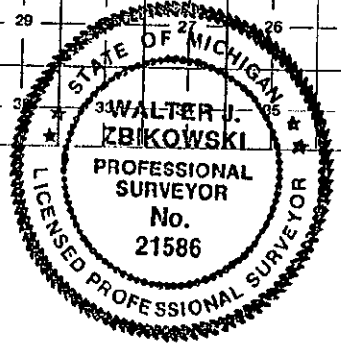

A. Description of original monument and accessories and/or subsequent restoration.
ORIGINAL GOVERNMENT SURVEY BY JOSEPH FLETCHER, D.S. (1815-1817)
G.L.O. (1816) EAST ON TRUE LINE BETWEEN T3 AND 4S., R10E., 81.00 CHAINS
COR SEC 31-32 T3S., R10E., (DESCRIPTION OF CORNER NOT STATED IN NOTES)
WITNESSES: BO 12" N 48 W 22 (LINKS) (14.52') (GONE)
POPLE 9" N 52 E 39 (LINKS) (25.74') (GONE)

\$10.00 DEED
RECORDED
FOREST E. YOUNGBLOOD, REGISTER OF DEEDS
WAYNE COUNTY, MI
SECTION 1828

SAME WITNESS FOR SEC COR 5,6 T.4S., R10E.
RESURVEY AT THE DIRECTION OF ALBERT CHAMPNEY, DIRECTOR OF WAYNE COUNTY BUREAU OF TAXATION
W.P.A. (1930's) CROSS ON STONE, SW-32 (#167)
WITNESSES: NNE 89.68' 10" ELM (GONE)
NE 47.84' SUB IRON (GONE)
ENE 38.16' ROAD SIGN POST (GONE)
SW 29.80' CROSS (ON SOUTH END) 36" CONC CULVERT (GONE)
NW 28.13' CROSS (ON NORTH END) 36" CONC CULVERT (GONE)

NOTE: SAME WITNESSES IN W.P.A. (1939) FOR STONE, NW-5 (T4S., R10E., (#11))

B. Description of corner evidence found and/or method applied in restoring or reestablishing corner.
FOUND A BROKEN CONCRETE MONUMENT UNDER AND OUTSIDE THE NORTHEAST RIM OF A ROAD BOX WITH LID (BOTH GOOD) AT THE CENTER OF THE INTERSECTION OF PENNSYLVANIA ROAD (A FIVE LANE ASPHALT ROAD) AND BEECH DALY ROAD (A FIVE LANE CONCRETE ROAD TO THE NORTH AND A GRAVEL ROAD TO THE SOUTH).

(CONTINUED ON BACK)

\$4.00 REMONUMENTATION

C. Description of monument for corner and accessories established to perpetuate locating the position of the corner.
C-13, SECTION CORNER 31-32, T.3S., R.10E., AND C-1 CORNER 5-6, T.4S., R.10E.,
MADE A 1/4" DRILL HOLE AT THE TRUE POSITION OF THE CORNER ATOP THE NORTHEAST RIM OF THE ROAD BOX OVER THE CENTER OF A BROKEN CONCRETE MONUMENT WITH RUSTED 1/2" IRON UNDER AND OUTSIDE A ROAD BOX WITH LID (BOTH GOOD) AT THE CENTER OF THE INTERSECTION OF PENNSYLVANIA ROAD (A FIVE LANE ASPHALT ROAD) AND BEECH DALY ROAD (A FIVE LANE CONCRETE ROAD TO THE NORTH AND A GRAVEL ROAD TO THE SOUTH). THE C-13 SECTION CORNER IS ACCEPTED AS A CAREFUL AND FAITHFUL PERPETUATION OF THE POSITION OF THE ORIGINAL CORNER AND IS COMMON WITH C-1, SECTION CORNER 5,6 T.4S., R.10E.
WITNESSES: N 43°01' W 67.53' FOUND PK NAIL WITH REFERENCE BRASS DISC ON EAST SIDE OF UTILITY POLE
N 51°55' E 87.65' SET NAIL WITH DISC ON SOUTHEAST SIDE OF A UTILITY POLE
S 44°51' E 64.50' SET NAIL WITH DISC ON SOUTHWEST SIDE OF A UTILITY POLE
S 43°56' W 68.65' FOUND "X" CUT IN EAST RIM OF GATE VALVE AND WELL

DID NOT PLACE ANY REMONUMENTATION BRASS DISC OR PVC CAP ON ABOVE BROKEN CONCRETE MONUMENT C-13, T.3S., R.10E., AND C-1, T.4S., R.10E., BUT REPLACED NAIL WITH AN LLS #21586 STAMPED REMONUMENTATION BRASS DISC ON THE SOUTHEAST SIDE OF THE UTILITY POLE IN THE NORTHEAST QUAD USED IN WITNESSES IN SECTION C AS THE ROAD BOX NEEDS TO BE REMOVED AND REPLACED IN A POSITION TO ACCESS SAID CONCRETE MONUMENT.

Signed by Walter J. Zbikowski
WALTER J. ZBIKOWSKI
Surveyor's Michigan License No. 21586

Date DEC. 8, 1997

P-100-10-11-20-11

DISTANCE TO B-13 MEASURED AS 2612.41'; G.L.O. (1817) RECORD DISTANCE OF 40.00 CHAINS; (2640.00');
 W.P.A. (1930's) RECORD DISTANCE OF 2612.17';
 DISTANCE TO C-12 MEASURED AS 2656.37'; G.L.O. (1817) RECORD DISTANCE OF 40.00 CHAINS; (2640.00');
 W.P.A. (1930's) RECORD DISTANCE OF 2656.23' AND 2656.53';
 DISTANCE TO D-13 MEASURED AS 2667.84'; G.L.O. (1817) RECORD DISTANCE OF 40.00 CHAINS (2640.00'); W.P.A.
 (1930's) RECORD DISTANCE OF 2667.64' AND 2667.64';
 W.C.R.C. (1973) MON. IN BOX, NW-5 (T4S., R10E.) #11 (NOTES INDICATE A COMMON CORNER)
 WITNESSES: NE 87.19' DE POLE (MEASURED 86.97')
 SE 76.20' "X" CUT NW COR SAN (STORM) MH (MEASURED 76.17')
 SW 84.17' "X" CUT NE COR WGW (MEASURED 84.01')
 NW 67.93' DE POLE (BENT NAIL WITH WCRC BRASS DISC) (MEASURED 67.79')
 NO OTHER KNOWN LCRC ON RECORD AT WAYNE COUNTY REGISTER OF DEEDS

SURVEY &
 REMONUMENTATION

MAR 17 1998

SECTION

FILE DO NOT MAIL