

**SURVEY & REMONUMENTATION**

DEC 02 1993

**RC 1098**

**LAND CORNER RECORDATION CERTIFICATE LI 26951 PA 719**  
 Filing Requirement of Act 74, Mich. P.A. 1970

**COMMISSION**

For corners in

<u>Wayne</u> (County)	Located In:	Corner Code <u>##</u>
1. Public Land Survey	T <u>4S</u> R <u>10E</u>	<u>C-2</u>
	T _____ R _____	_____
	T _____ R _____	_____
	T _____ R _____	_____
2. Property Controlling in Section	S _____ T _____ R _____	_____
	S _____ T _____ R _____	_____
3. Miscellaneous Property in Sec.	S _____ T _____ R _____	_____
	S _____ T _____ R _____	_____
4. Lot No. _____, Recorded Plat _____		
5. Private Claims _____		

Compliance with ACT 345, P.A. 1990  
 APPROVED ON: 10-28-93 *DL*  
 WAYNE COUNTY REMONUMENTATION PEER GROUP COMMITTEE

Register of Deeds Stamp & File Number

RC 1098

I, Bruce Antcliff, in a field survey on August 23, 19 93, do hereby certify that under requirements of P.A. 74, Michigan P.A. of 1970, the corner points mentioned in lines 1 and 2 above were in conformance with regulations and rules therefore as required in the current manual of survey instructions of the United States Department of the Interior, Bureau of Land Management or by a decree of a Court of Law and/or that the corner points mentioned in lines 3, 4 and 5 above were in conformance with the rules of the Michigan Board of Land Surveyors or by a Decree of a Court of Law; established, re-established, monumented, re-monumented, recovered, found as expressed below:

**NOTE: Not more than 4 corners, all in the same town and range, may be recorded on this certificate.**

A. Description of original monument and accessories and/or subsequent restoration:

- GLO-Post
- WPA (1930's)- Iron
- LCRC (1973) - Iron Pipe (L18356, P 860)
- LCRC (1974)-1/2" Iron Pipe (L 18772, P 24)

B. Description of corner evidence found and/or method applied in restoring or reestablishing corner:

- 1/2" ID Pipe; Measured to SW S.5-
- Checked well with WPA Surveys.

C. Description of monument for corner and accessories established to perpetuate locating the position of the corner:

Set 4" X 36" Conc. Monument w/Wayne County Remonumentation Marker and Cap #25826 in monument box

Witnesses


- \*+ Top S. End east bridge abutment, NE, 86.89'
- Punch mark in fence post, E, 62.00'
- P.K. W'y side 12" oak, SE, 99.87'
- \*+ E'y edge rim of gate valve, SW, 66.66'
- WCRC nail & tag NE'y side MBT Pole, NW, 56.59'

The selected location is accepted by the Contractor and is generally accepted by professional surveyors as the best available evidence of the position of the original corner.

Signed by Bruce Antcliff Date 11-10-93  
 Surveyor's Michigan License No. 25826

	A	B	C	D	E	F	G	H	I	J	K	L	M
2	6	5	4	3	2	1							
3													
4	7	8	9	10	11	12							
5													
6	18	17	16	15	14	13							
7													
8	19	20	21	22	23	24							
9													
10	30	29	28	27	26	25							
11													
12	31	32	33	34	35	36							
13													

93 NOV 10 PM 2:15  

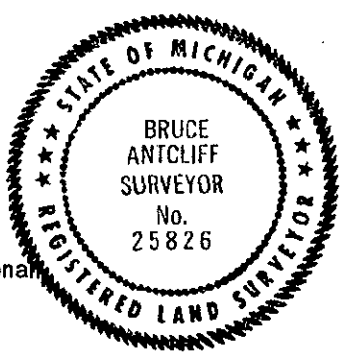

*20  
110*