

SURVEY & REMONUMENTATION

DEC 02 1993

RC 1099

LAND CORNER RECORDATION CERTIFICATE
Filing Requirement of Act 74, Mich. P.A. 1970

LI 26951 PA 720

COMMISSION

For corners in

| Wayne (County) | Located In: | Corner Code # |
|------------------------------------|-------------------------|---------------|
| 1. Public Land Survey | T 4S. R 10E | C-3 |
| | T _____ R _____ | _____ |
| | T _____ R _____ | _____ |
| | T _____ R _____ | _____ |
| 2. Property Controlling in Section | S _____ T _____ R _____ | _____ |
| | S _____ T _____ R _____ | _____ |
| 3. Miscellaneous Property in Sec. | S _____ T _____ R _____ | _____ |
| | S _____ T _____ R _____ | _____ |

Compliance with
 ACT 345, P.A. 1990
 APPROVED ON: 10-28-93 *PL*
 WAYNE COUNTY REMONUMENTATION
 PEER GROUP COMMITTEE

RC 1099

Register of Deeds Stamp & File Number

4. Lot No. _____, Recorded Plat _____
 5. Private Claims _____

| | A | B | C | D | E | F | G | H | I | J | K | L | M |
|----|----|---|----|---|----|---|----|---|----|---|----|---|---|
| 2 | 6 | | 5 | | 4 | | 3 | | 2 | | 1 | | |
| 3 | | | | | | | | | | | | | |
| 4 | 7 | | 8 | | 9 | | 10 | | 11 | | 12 | | |
| 5 | | | | | | | | | | | | | |
| 6 | 18 | | 17 | | 16 | | 15 | | 14 | | 13 | | |
| 7 | | | | | | | | | | | | | |
| 8 | 19 | | 20 | | 21 | | 22 | | 23 | | 24 | | |
| 9 | | | | | | | | | | | | | |
| 10 | 30 | | 29 | | 28 | | 27 | | 26 | | 25 | | |
| 11 | | | | | | | | | | | | | |
| 12 | 31 | | 32 | | 33 | | 34 | | 35 | | 36 | | |
| 13 | | | | | | | | | | | | | |

I, Bruce Antcliff, in a field survey on August 25, 1993, do hereby certify that under requirements of P.A. 74, Michigan P.A. of 1970, the corner points mentioned in lines 1 and 2 above were in conformance with regulations and rules therefore as required in the current manual of survey instructions of the United States Department of the Interior, Bureau of Land Management or by a decree of a Court of Law and/or that the corner points mentioned in lines 3, 4 and 5 above were in conformance with the rules of the Michigan Board of Land Surveyors or by a Decree of a Court of Law; established, re-established, monumented, re-monumented, recovered, found as expressed below:

NOTE: Not more than 4 corners, all in the same town and range, may be recorded on this certificate.


A. Description of original monument and accessories and/or subsequent restoration:
 GLO-Post
 WPA (1930's)- Iron over stone

B. Description of corner evidence found and/or method applied in restoring or reestablishing corner:
 Conc. Mon. in Mon. Box - Measured to W1/4 S.5, S1/4 S.5, and S1/4 S.6
 Distances checked well with WPA Surveys.

C. Description of monument for corner and accessories established to perpetuate locating the position of the corner:
 Set Wayne County Remonumentation Marker and Cap #25826 on existing monument.

Witnesses
 P.K. Nail W. face 15" oak, SE, 37.81'
 Top Cen. Fire Hydrant, SW, 52.40'
 Nail & WCRC Tag NE Face P.P., NW, 49.88'
 P.K. Nail SW Face P.P., NNW, 136.83'

The selected location is accepted by the Contractor and is generally accepted by professional surveyors as the best available evidence of the position of the original corner.

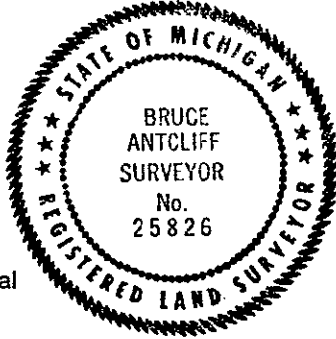

Signed by Bruce Antcliff Date 11-10-93
 Surveyor's Michigan License No. 25826

Handwritten initials and date: 20 11/11