

LAND CORNER RECORDATION CERTIFICATE
Filing Requirement of Act 74, Mich. P.A. 1970

L129360PA583


For corners in

<u>WAYNE</u> (County)	Located in: <u>Brownstown</u> Township	Corner Code # <u>C-4</u>
1. Public Land Survey	T <u>4S</u> R <u>10E</u>	<u>C-4</u>
	T _____ R _____	_____
	T _____ R _____	_____
	T _____ R _____	_____
2. Property Controlling in Section	S _____ T _____ R _____	_____
	S _____ T _____ R _____	_____
3. Miscellaneous Property in Sec.	S _____ T _____ R _____	_____
	S _____ T _____ R _____	_____

Compliance with
ACT 345, P.A. 1990 *JBJ*
APPROVED ON: DEC. 17, 1996
WAYNE COUNTY REMONUMENTATION
PEER GROUP COMMITTEE
 Register of Deeds Stamp & File Number

4. Lot No. _____, Recorded Plat _____
 5. Private Claims _____

I, Randy Kolehouse, in a field survey on November 27 19 96, do hereby certify that under requirements of P.A. 74 Michigan P.A. of 1970, the corner points mentioned in lines 1 and 2 above were in conformance with regulations and rules therefore as required in the current manual of survey instructions of the United States Department of the interior, Bureau of Land Management or by a decree of a Court of Law and/or that the corner points mentioned in lines 3, 4 and 5 above were in conformance with the rules of the Michigan Board of Land Surveyors or by a Decree of a Court of Law; established, re-established, monumented, re-monumented, recovered, found as expressed below:

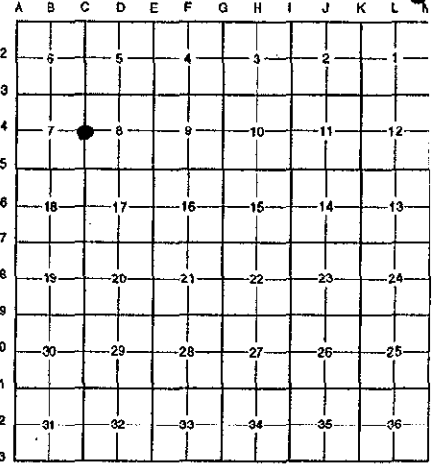

NOTE: Not more than 4 corners, all in the same town and range, may be recorded on this certificate.

A. Description of original monument and accessories and/or subsequent restoration:

C-4	1817	G.L.O.	Fletcher	Notes
	1930's	WPA Notes	N/A	Section Map and Ties
	1975	Cert. Survey	Stanley #12031	L. 19211 P. 229-230

\$ 4.00 REMONUMENTATION
 Post.00 DEED
 Iron DEC 96 12:44 P.M. RECEI A
 Pipe RECORDED
 FOREST E. YOUNGBLOOD, REGISTER EDS
 WAYNE COUNTY, MI

B. Description of corner evidence found and/or method applied in restoring or reestablishing corner:

C-4 Found a 1-1/2" pipe with capped iron #4054 inside, 73' ± East of fence corner (fence running East and South) and 0.65' North of East-West fence line. No WPA witnesses remain. Cert. Survey L. 19211 P. 229 by Gary Stanley illustrates the NE corner of parcel "B" to be 74.8' West of C-4. Found fence corner running East and South from a point 73' M/L West and also 1-1/2" iron 74.9' West of this iron which would check the Stanley survey. Calculated distance from C-5 to C-4 from Stanley survey of 2627.4 and angle at C-5 West-North of 89° 01' 57", both of which check the WPA survey.

Measure North to C-3 2683.88' (WPA = 2683.05') (G.L.O. = 2640.0')
 Measure South to C-5 1627.02' (WPA = 2627.6') (G.L.O. = 2640.0') (Calc. Dist. from Survey L. 19211 P. 229 = 2627.40')


C. Description of monument for corner and accessories established to perpetuate locating the position of the corner:

C-4 Set 1/2" rebar, brass "Wayne Co. Remon." disk and survey cap #25854 inside existing 1-1/2" pipe.

- Nail w/Tag #4054 in NE Face 15" Apple N 37° W 20.30'
- Nail w/Tag #4054 in W Face 30" Elm N 20° E 11.23'
- Fence Post S 78° W 3.81'
- Fence Post S 65° E 6.47'
- 1-1/2" Iron West 74.90'

The selected location is accepted by the Contractor and is generally accepted by professional surveyors as the best available evidence of the position of the original corner.

Signed by Randy J. Kolehouse Date 12/24/96
 Surveyor's Michigan License No. 25854

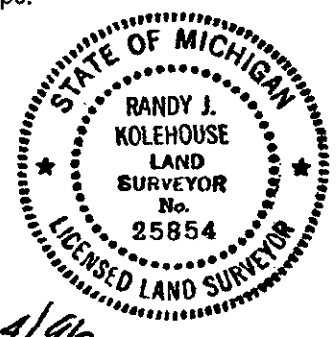

4R
7D
JBJ