

**LAND CORNER RECORDATION CERTIFICATE**  
**Filing Requirement of Act 74, Mich. P.A. 1970**

**LI29360 PA586**


For corners in

|                                       |                                    |                      |
|---------------------------------------|------------------------------------|----------------------|
| <u>WAYNE</u><br>(County)              | Located in: Brownstown<br>Township | Corner Code #<br>C-8 |
| 1. Public Land Survey                 | T <u>4S</u> R <u>10E</u>           | <u>C-8</u>           |
|                                       | T _____ R _____                    | _____                |
|                                       | T _____ R _____                    | _____                |
|                                       | T _____ R _____                    | _____                |
| 2. Property Controlling<br>in Section | S _____ T _____ R _____            | _____                |
|                                       | S _____ T _____ R _____            | _____                |
| 3. Miscellaneous<br>Property in Sec.  | S _____ T _____ R _____            | _____                |
|                                       | S _____ T _____ R _____            | _____                |
| 4. Lot No. _____, Recorded Plat _____ |                                    |                      |
| 5. Private Claims _____               |                                    |                      |

Compliance with  
**ACT 345, P.A. 1990** *78J*  
**APPROVED ON: DEC. 17, 1996**  
**WAYNE COUNTY REMONUMENTATION**  
**PEER GROUP COMMITTEE**  
 Register of Deeds Stamp & File Number

96326800

I, Randy Kolehouse, in a field survey on November 27 19 96, do hereby certify that under requirements of P.A. 74 Michigan P.A. of 1970, the corner points mentioned in lines 1 and 2 above were in conformance with regulations and rules therefore as required in the current manual of survey instructions of the United States Department of the Interior, Bureau of Land Management or by a decree of a Court of Law and/or that the corner points mentioned in lines 3, 4 and 5 above were in conformance with the rules of the Michigan Board of Land Surveyors or by a Decree of a Court of Law; established, re-established, monumented, re-monumented, recovered, found as expressed below:

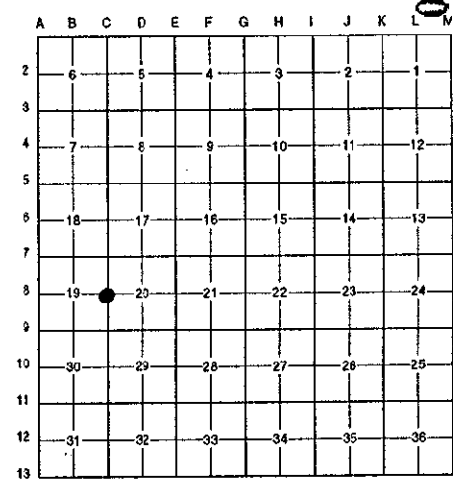

**NOTE: Not more than 4 corners, all in the same town and range, may be recorded on this certificate.**

A. Description of original monument and accessories and/or subsequent restoration:

|     |        |           |          |                      |      |
|-----|--------|-----------|----------|----------------------|------|
| C-8 | 1817   | G.L.O.    | Fletcher | Notes                | Post |
|     | 1930's | WPA Notes | N/A      | Section Map and Ties | Iron |
|     | 1973   | W.C.R.C.  | Coon     | Witness Record       | Iron |

B. Description of corner evidence found and/or method applied in restoring or reestablishing corner:

C-8 Found a 1/2" pipe at the East end of fence and brush row running West on North side of wood fence post (with W.C.R.C. nail and tags). Post has fallen down but appears to be the same as the fence post 0.93' South of corner as called for in W.C.R.C. witnesses (1973). This corner checks the following W.C.R.C. witnesses:

W.C.R.C. Witness Record (1973)  
 Fence post S 0.93'  
 4" Ash WSW 10.79' (m. 10.86 C/L 15")

\$ 4.00 REMONUMENTATION  
 \$ 7.00 DEED  
 26 DEC 96 12:44 P.M. RECEI A  
 RECORDED  
 FOREST E. YOUNGBLOOD, REGISTER EDS  
 WAYNE COUNTY, MI


Measure North to C-7 2643.20' (WPA = 2643.5') (G.L.O. = 2640.0')  
 Measure South to C-9 2628.56' (WPA = 2628.5') (G.L.O. = 2640.0')

C. Description of monument for corner and accessories established to perpetuate locating the position of the corner:

C-8 Replaced an existing 1/2" pipe with a 1/2" rebar, brass "Wayne Co. Remon disk and survey cap #25854.

Magnetic Nail in N Face 12" Cherry N 56° W 5.67'  
 P.K. Nail w/Tag #10705 in N Face 12" Cherry N 56° W 4.87'  
 P.K. Nail in N Face 15" Ash N 69° W 10.86'  
 On line of fence and brush row running West

The selected location is accepted by the Contractor and is generally accepted by professional surveyors as the best available evidence of the position of the original corner.

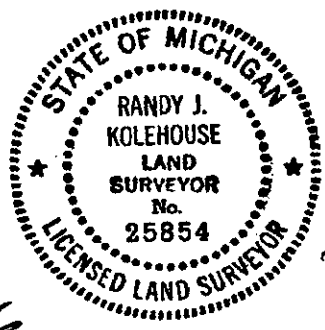

Signed by Randy J. Kolehouse Date 12/24/96  
 Surveyor's Michigan License No. 25854