

SURVEY & REMONUMENTATION

APR 25 1995

RC 1600

LAND CORNER RECORDATION CERTIFICATE Filing Requirement of Act 74, Mich. P.A. 1970

COMMISSION

For corners in

WAYNE
(County)

Located In: Brownstown Corner Code #
Township

- | | | | |
|---------------------------------------|-------------|--------------|------------|
| 1. Public Land Survey | T <u>4S</u> | R <u>10E</u> | <u>C-9</u> |
| | T _____ | R _____ | _____ |
| | T _____ | R _____ | _____ |
| | T _____ | R _____ | _____ |
| 2. Property Controlling
in Section | S _____ | T _____ | R _____ |
| | S _____ | T _____ | R _____ |
| 3. Miscellaneous
Property in Sec. | S _____ | T _____ | R _____ |
| | S _____ | T _____ | R _____ |
4. Lot No. _____, Recorded Plat _____
5. Private Claims _____

LI27800PA667

Compliance with
ACT 345, P.A. 1990

APPROVED ON: 12-7-94
WAYNE COUNTY REMONUMENTATION
PEER GROUP COMMITTEE

Register of Deeds Stamp & File Number

RC 1600


I, Randy Kolehouse, in a field survey on August 3 19 94, do hereby certify that under requirements of P.A. 74 Michigan P.A. of 1970, the corner points mentioned in lines 1 and 2 above were in conformance with regulations and rules therefore as required in the current manual of survey instructions of the United States Department of the Interior, Bureau of Land Management or by a decree of a Court of Law and/or that the corner points mentioned in lines 3, 4 and 5 above were in conformance with the rules of the Michigan Board of Land Surveyors or by a Decree of a Court of Law; established, re-established, monumented, re-monumented, recovered, found as expressed below:

NOTE: Not more than 4 corners, all in the same town and range, may be recorded on this certificate.

A. Description of original monument and accessories and/or subsequent restoration:

C-9	1817	G.L.O. Notes	N/A	Post
	1930's	WPA Notes	N/A	N/A
	1972	L.C.R.C. #123 L. 18145 P. 506	Papke	Iron
	1973	WCRC Notes	N/A	Monument
	1973	MDSH	Munoz	Mon. w/1/4" Iron
	1976	MDSH	Suriboda	Mon. in Box

\$ 13.00 MISCELLANEOUS RECORDING
28 DEC 94 9:41 A.M. RECEIPT
RECORDED
FOREST E. YOUNGBLOOM, REGISTER (I)
WAYNE COUNTY, MI

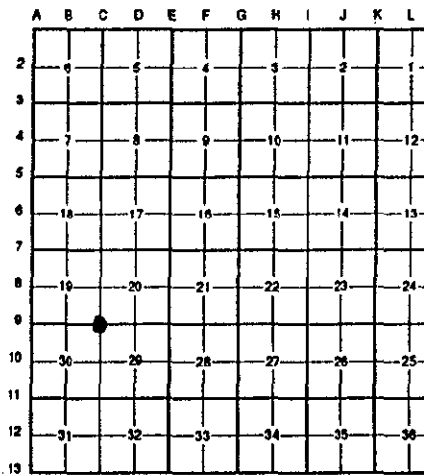

B. Description of corner evidence found and/or method applied in restoring or reestablishing corner:

C-9 I found 1/2" rebar in monument box at C/L of Van Horn Road (asphalt) and agrees with the following witnesses.

L.C.R.C. #123 & MDSH Witnesses 1973 & 1976
C/L San. M.H. NE 45.80'
Prop. Cor. North 60.00'


WCRC Notes
Iron N'y 52.98' (53.01' m)
Nail & Tag 16" Box Elder NE'y 84.00' (83.79' m to P.K. 30" Elm)
"+ SW Rim San. M.H. NE'y 44.80' (45.90' m to C/L)

Measures East to D-9 = 2635.96' (G.L.O. = 2623.50') (WPA = 2635.89') (MDSH = 2636.12')
Measures South to C-10 = 2649.47' (G.L.O. = 2640') (WPA = 2649.75')
Measures West to B-9 = 2660.65' (G.L.O. = 2640') (WPA = 2660.62' S-19 - WPA = 2661.06' S-30)

C. Description of monument for corner and accessories established to perpetuate locating the position of the corner:

C-9 I set an aluminum cap stamped "Wayne Co. Remon." on existing iron in an existing monument box.

Iron w/Cap "RLS #12031" N 14° E 60.01'
P.K. in S Face Util. Pole N 71° E 118.66'
P.K. in NW Face Util. Pole S 50° W 72.89'
P.K. in SW Face Util. Pole N 41° W 72.92'

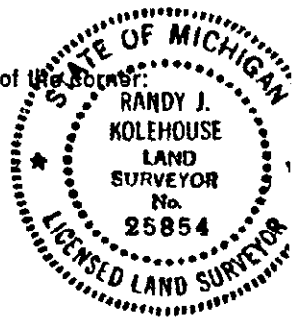

The selected location is accepted by the Contractor and is generally accepted by professional surveyors as the best available evidence of the position of the original corner.

Signed by Randy J. Kolehouse Date 12/14/94
Surveyor's Michigan License No. 25854

2 R
11
ML